

**Springville City
BARTHOLOMEW WATER TANK
Contract Documents**

ADDENDUM #02

June 07, 2018

To all Plan Holders:

You are hereby notified that the following changes, clarifications, and/or corrections have been made to the Contract Documents and Specifications, and /or Drawings for the above referenced project.

This ADDENDUM consisting of 18 page(s) shall be made part of the contract documents, and all provisions of the Contract shall apply thereto.

Proposers shall acknowledge receipt of this addendum in the space provided in the Bid Form.

CONTRACT DOCUMENTS AND SPECIFICATIONS

1. Specification Section 00310 – Bid Schedule
 - a. Revised Bid Item 4 to include an estimated excavation of 6,075 cubic yards.
 - b. Added Bid item 24 for Tank Foundation Drain
 - c. Added Bid item 25 for building permits fee, estimated cost is \$9,500.00
2. Specification Section 01025 – Measurement and Payment
 - a. Revised Bid Item 3 to read:

“Payment shall be considered full compensation for all labor, equipment and materials necessary for removing, hauling and disposing of trees, stumps, tree debris, plant life, root systems and shrubs.”
 - b. Revised Bid Item 4 to read:

“Payment shall be considered full compensation for all labor, equipment and materials necessary to excavate, remove, haul off to a location 1/4 mile away, and backfill as required. Payment includes any necessary hauling, trucking and disposal fees.”
 - c. Added Bid Item 24, Tank Drain Foundation, which reads:

“Payment shall be considered full compensation for all labor, equipment, required fill and materials necessary to construct and install foundation drain system. Includes fill as shown on drawing, piping, back water valve, reducers and fittings to connect into tank drain piping.”
 - d. Added Bid Item 25, Building Permits, which reads:

“Building permit, plan check and third party review fees will be reimbursed at actual cost.”

CONTRACT DRAWINGS

1. Site and Civil Drawings
 - a. Replace drawings C-101, P-101, C-301 and DT-02 with revision 1 drawings. Revision include:
 1. Realignment of existing pipe and relocation of Weir Box, changing Weir Box Drain line to ADS material, adding foundation drain with tie-in to tank drain and revising drain outlet screen call-out.
2. Tank and Weir Structural Drawings

- a. Replace/Add drawing S1-102, S1-103, S1-301, S1-502, S1-601, S2-101, S2-202 and S2-502 with revision 1 drawings. Revisions include:
 - 1. Addition of Tank Foundation Drain Field with cross section, clarity of roof slab thickness, increased curb height for access hatch, revised access hatch type and additional detail on the weir box hatch.

- END OF ADDENDUM -

SECTION 00310

BID SCHEDULE

1.01 PROJECT IDENTIFICATION

A. Name: Bartholomew Water Tank

B. Submitted to: Springville City
110 South Main
Springville City, Utah 84663

1.02 RELATED SECTIONS

Section 01025: Measurement and Payment

1.03 SCHEDULES TO BE ADDED TO THE AGREEMENT

This Bid Schedule contains the schedule of values which will be incorporated into the Agreement (Section 00500) by reference.

1.04 BID SCHEUDLE

A. Approach To Work and Constraints

The following shall be considered in preparing the Bid Schedule:

1. Excess excavated native soils may be placed within a ¼ mile of the project site.
2. Access through the job site shall be provided at all times.
3. Night work will be allowed (if requested), but not required.
4. Cost of mobilization is limited to no greater than 5% of the cost of construction.

B. Schedule of Values

ITEM	DESCRIPTION	ESTIMATED QUANTITY	UNIT	UNIT COST	TOTAL AMOUNT
1	Mobilization	1	LS		\$
2	Construction Staking	1	LS		\$
3	Site clearing	1	LS		\$
4	Water tank excavation	6,075	CY		\$
5	500,000 gallon water tank	1	LS		\$
6	Weir structure	1	LS		\$

7	Meter vault (Detail 4, sheet DT-01)	1	LS		\$
8	24-inch ductile iron pipe	150	LF		\$
9	20-inch ductile iron pipe	55	LF		\$
10	24-inch ADS drain pipe	95	LF		\$
11	12 inch PVC pipe	205	LF		\$
12	Connecting to existing 20-inch waterline (Detail 2 & 3, sheet DT-01)	2	EA		\$
13	24-inch butterfly valves	2	EA		\$
14	20-inch butterfly valves	2	EA		\$
15	12-inch butterfly valve	1	EA		\$
16	Air/Vacuum valve and structure	1	LS		\$
17	Tank drain outlet (Detail 6, sheet DT-02)	1	LS		
18	Chlorine Injection and Chlorine water line (Injection Detail, sheet DT-01 and Detail 5, Sheet DT-01)	1	LS		\$
19	Remove and reuse existing fence	175	LF		\$
20	Security Fence	175	LF		\$
21	Final grading and seeding		SF		\$
22	Electrical work	1	LS		\$
23	Overflow Junction Box	1	LS		\$
24	Tank Foundation Drain	1	LS		\$
25	Building Permits		LS		\$9,500
BID TOTAL					\$

1.05 BIDDER'S ACKNOWLEDGEMENT

The BIDDER acknowledges to the OWNER that the BID provided herein includes total cost required to build a fully functioning project including all work, materials, appurtenances, accessories, and related items as outlined within these specifications and shown in the drawings.

COMPANY: _____

Signed: _____

Title: _____

Date: _____

- END OF SECTION -

BID ITEM	ITEM	METHOD OF MEASUREMENT	BASIS OF PAYMENT
			DELETE THIS PAGE - JUST USED TO ADJUST PAGE NUMBERING
1	Mobilization	Not measured; paid for on a lump sum basis	<p>Payment shall be considered full compensation for general and miscellaneous responsibilities and operations not normally attributed to any other single bid item within this schedule. This shall include, but is not limited to, work described or enumerated in Section 01505, Mobilization and mobilizing to and from the project, clean-up, temporary utilities, payment and performance bonding, insurance, permits, and pre-construction video records.</p> <p>Work completed under this bid item shall be paid for at the contract lump sum price in accordance with the following schedule:</p> <p>a. At 10% of project completion, 25% of the lump sum amount will be paid.</p> <p>b. At 25% of project completion, 50% of the lump sum amount will be paid.</p> <p>c. At 50% of project completion, 75% of the lump sum amount will be paid.</p> <p>d. At 75% of project completion, 100% of the lump sum amount will be paid.</p>
2	Construction Staking	Not measured; paid for on a lump sum basis	Payment shall be considered full compensation for all labor, equipment and materials necessary for all staking necessary for construction location.
3	Site Clearing	Not measured; paid for on a lump sum basis.	Payment shall be considered full compensation for all labor, equipment and materials necessary for removing, hauling and disposing of trees, stumps, tree debris, plant life, root systems and shrubs.
4	Water tank excavation	Cubic yard of material removed	Payment shall be considered full compensation for all labor, equipment and materials necessary to excavate, remove, haul off to a location 1/4 mile away, and backfill as required. Payment includes any necessary hauling, trucking and disposal fees.
5	500,000 gallon water tank	Not measured; paid for on a lump sum basis.	Payment shall be considered full compensation for all labor, equipment and materials necessary to construct one fully functioning 500,000 gallon reinforced concrete water tank, roof columns, roof and tank appurtenances, such as but not limited to, drain, overflow, inlet, hatch, ultrasonic level sensor, level sensor mount, level sensor housing, etc.

BID ITEM	ITEM	METHOD OF MEASUREMENT	BASIS OF PAYMENT
6	Weir structure	Not measured; paid for on a lump sum basis.	Payment shall be considered full compensation for all labor, equipment and materials necessary to construct one fully functioning reinforced concrete weir structure, cover, hatch, inlets and outlets and weir plate supply and installation. Work includes excavation, dewatering, shoring, building the new weir structure around existing 30" water line, cutting and removing existing water line, patching structure walls as necessary when pipe is removed, capping the existing pipe on the south side of the structure, backfill and compaction around structure. The spring flow is only allowed to be interrupted for 1 week maximum.
7	Meter vault (Detail 4, sheet DT-01)	Not measured; paid for on a lump sum basis.	Payment shall be considered full compensation for all labor, equipment and materials necessary to construct and install one 8' x 8' precast meter vault. Includes excavation, setting of precast vault with sump with protective grating, cover, hatch, sample tap electromagnetic flow meter, piping and fittings, backfill, compaction and incidental work required.
8	24-inch ductile iron pipe	Linear foot of pipe installed.	Payment shall be considered full compensation for all labor, equipment and materials necessary to furnish and install 24-inch ductile iron pipe (tank inlet, outlet and overflow piping); including excavation, trench shoring, dewatering, fittings to connection to new tank and achieve required elevations, thrust blocking, bedding, backfill, compaction and incidental work required. Compensation to also include 30-inch ductile iron pipe and 30"x24" reducer to connect to new weir structure.
9	20-inch ductile iron pipe	Linear foot of pipe installed.	Payment shall be considered full compensation for all labor, equipment and materials necessary to furnish and install 20-inch ductile iron pipe (hydro plant line and outlet after mag meter); including excavation, trench shoring, dewatering, fittings to connection to weir structure and achieve required elevations, bedding, backfill, compaction and incidental work required.
10	24-inc ADS drain pipe	Linear foot of pipe installed.	Payment shall be considered full compensation for all labor, equipment and materials necessary to furnish and install 24-inch ADS pipe (weir drain line); including excavation, shoring, dewatering, connection to new weir structure and drain junction box, fittings, bedding, compaction and incidental work required.
11	12-inch ductile iron pipe	Linear foot of pipe installed.	Payment shall be considered full compensation for all labor, equipment and materials necessary to furnish and install 12-inch ductile iron pipe (tank drain line); including excavation, trench shoring, dewatering, connection to water tank, fittings, thrust blocking, bedding, backfill, compaction and incidental work required.
12	Connection to existing 20-inch waterline (Detail 2 & 3, sheet DT-01)	Each connection made.	Payment shall be considered full compensation for all labor, equipment and materials necessary to connect to existing 20-inch Hydro outlet; including excavation, trench shoring, dewatering, bedding, backfill, compaction and incidental work required. Not including valves.


BID ITEM	ITEM	METHOD OF MEASUREMENT	BASIS OF PAYMENT
13	24-inch butterfly valves	Each valve installed.	Payment shall be considered full compensation for all labor, equipment and materials necessary to install 24-inch butterfly valves; including excavation, trench shoring, dewatering, bedding, valve box, valve stem extensions, backfill, compaction and incidental work required.
14	20-inch butterfly valves	Each valve installed.	Payment shall be considered full compensation for all labor, equipment and materials necessary to install 20-inch butterfly valves; including excavation, trench shoring, dewatering, bedding, valve box, valve stem extensions, backfill, compaction and incidental work required.
15	12-inch butterfly valves	Each valve installed.	Payment shall be considered full compensation for all labor, equipment and materials necessary to install 12-inch butterfly valve; including excavation, trench shoring, dewatering, bedding, valve box, valve stem extensions, backfill, compaction and incidental work required.
16	Air/Vacuum valve and structure	Not measured; paid for on a lump sum basis.	Payment shall be considered full compensation for all labor, equipment and materials necessary to install water air-vac; including excavation, trench shoring, dewatering, manhole, fittings and appurtenances, backfill, compaction and incidental work required.
17	Tank drain outlet (Detail 6, Sheet DT-02)	Not measured; paid for on a lump sum basis.	Payment shall be considered full compensation for all labor, equipment and materials necessary to furnish and install 12-inch drain outlet; including excavation, trench shoring, dewatering, fittings, steel gooseneck, screen, thrust blocking, bedding, backfill, compaction, riprap and incidental work required.
18	Chlorine Injection and Chlorine water line (Injection Detail, sheet DT-01 and Detail 5, Sheet DT-01)	Not measured; paid for on a lump sum basis.	Payment for Chlorine Injection line shall be considered full compensation for all labor, equipment and materials necessary to install chlorine injector into new 24-inch ductile iron pipe; including excavation, trench shoring, dewatering, manhole, fittings and appurtenances, connection to existing HDPE pipe, backfill, compaction and incidental work required. Payment for Chlorine water line shall be considered full compensation for all labor, equipment and materials necessary to install chlorine water line into new 20-inch ductile iron pipe; including excavation, trench shoring, dewatering, valve box, fittings and appurtenances, connection to existing HDPE pipe, backfill, compaction and incidental work required.
19	Remove and reuse existing fence	Linear foot of fence installed.	Payment shall be considered full compensation for all labor, equipment and materials necessary to remove existing fencing as indicated in the plan set; chain link to be reused and installed as part of the new security fence.
20	Security fence	Linear foot of fence installed.	Payment shall be considered full compensation for all labor, equipment and materials necessary to install remaining new security fence; posts to be furnished and installed for both reused and new portions of the new security fence as required.
21	Final grading and seeding	Not measured; paid for on a lump sum basis.	Payment shall be considered full compensation for all labor, equipment and materials necessary for backfill, grade and reseed with the forest service seed mixture in all areas affected.

BID ITEM	ITEM	METHOD OF MEASUREMENT	BASIS OF PAYMENT
22	Electrical work	Not measured; paid for on a lump sum basis.	Payment shall be considered full compensation for all labor, equipment, materials and coordination necessary to meeting electrical installation requirements; including, but not limited to: furnishing the conduit and all necessary fittings, excavation, installing the conduit, bedding, backfilling, compaction, cable, connections, and all other operations and materials required to complete this portion of the work as shown on the electrical drawings.
23	Overflow Junction Box	Not measured; paid for on a lump sum basis.	Payment shall be considered full compensation for all labor, equipment and materials necessary to construct and install one 4' x 4' precast meter vault. Includes excavation, setting of precast vault, cover, piping and fittings, pipe support, screen, backfill, compaction, riprap swell to channel and incidental work required.
24	Tank Foundation Drain	Not measured; paid for on a lump sum basis.	Payment shall be considered full compensation for all labor, equipment, required fill and materials necessary to construct and install foundation drain system. Includes fill as shown on drawing, piping, back water valve, reducers and fittings to connect into tank <u>drain piping</u> .
25	Building Permits	Not measured; paid for on a lump sum basis.	Building permit, plan check and third party review fees will be reimbursed at actual cost.

Point #	Northing	Easting	Elevation	Latitude	Longitude	Description
100	252361.642	638771.892	6253.51	40°13'19.73687"	111°30'29.12260"	CP-TANK1 rebar with cap stamped "SURVEY CONTROL"

Bartholomew Canyon Seed Mixture
 Replant vegetation after final grading

Scientific Name	lbs/acre
Bromus marginatus	4
Bouteloua curtipendula	3
Penstemon strictus	2

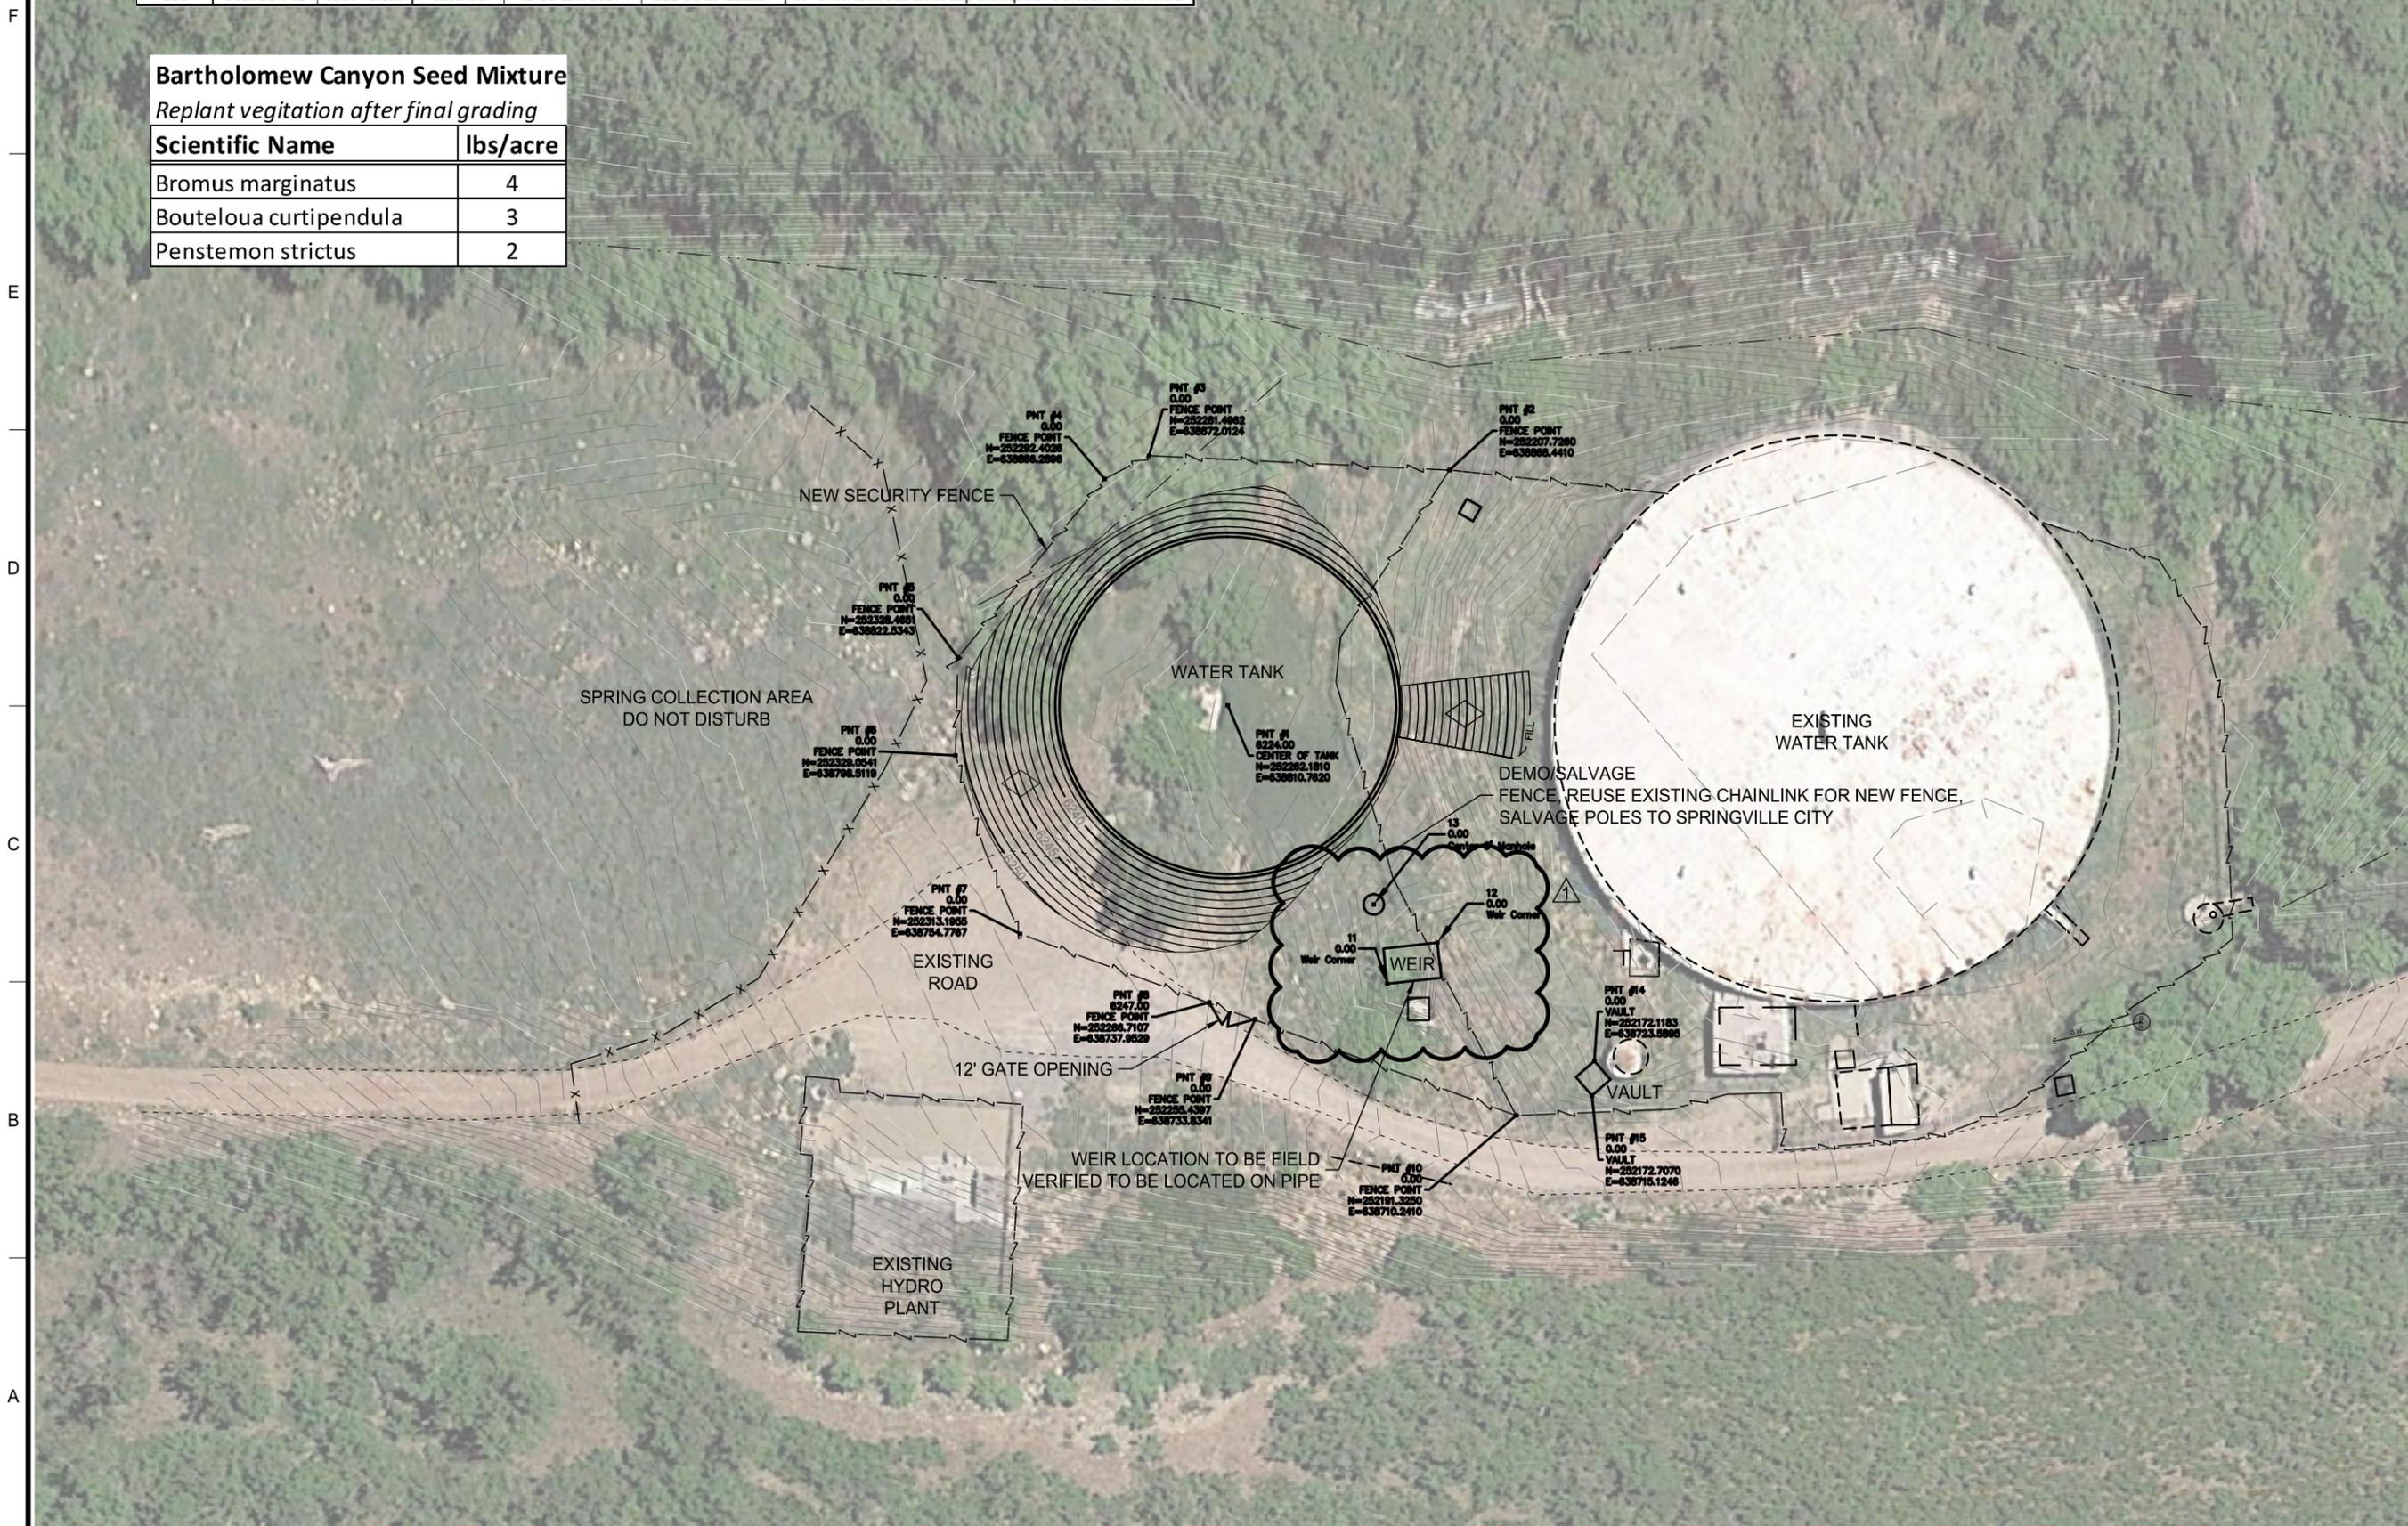

NO.	1	DATE	6/7/18
REVISIONS			
ADDENDUM 2			
REMARKS			
DWG NAME: H:\JUD\Proj\1802-207.dwg			
PROJECT DESIGN ENGINEER			
QUALITY MANAGEMENT REVIEW			
SCALE:	1" = 40'		
UPDATED:	6/7/2018		
PLOTTED:	6/7/2018		


Jones & DeMille Engineering, Inc.
 CIVIL ENGINEERING - SURVEYING - TESTING
 GIS - ENVIRONMENTAL
 1.800.748.5275 www.jonesanddemic.com

APPROVAL RECOMM: _____ DATE: _____
 APPROVED: _____ DATE: _____
 PROJECT DESIGN ENGINEER: _____ DATE: _____
 QUALITY MANAGEMENT REVIEW: _____ DATE: _____



PROJECT NUMBER:	1802-207
SITE & SURVEY CONTROL	
BARTHOLOMEW WATER TANK	
SPRINGVILLE CITY	

NOTES:

- ① CUT EXISTING HDPE DR-17 CHEMICAL SOLUTION PIPING AND CONNECT TO EXTEND TO NEW LOCATIONS WITH HDPE DR-17 PIPING.
- ② CUT, PLUG AND ABANDON 30 INCH SPRING PIPE
- ③ INSTALL 2" AIR/VAC VALVE PER SPRINGVILLE CITY DETAIL.
- ④ TAP NEW DUCTILE IRON PIPE FOR CHLORINE INJECTION WITHIN 5' Ø MANHOLE.
- ⑤ TOP OF WEIR CREST TO BE SET AT ELEVATION 6237.25'.

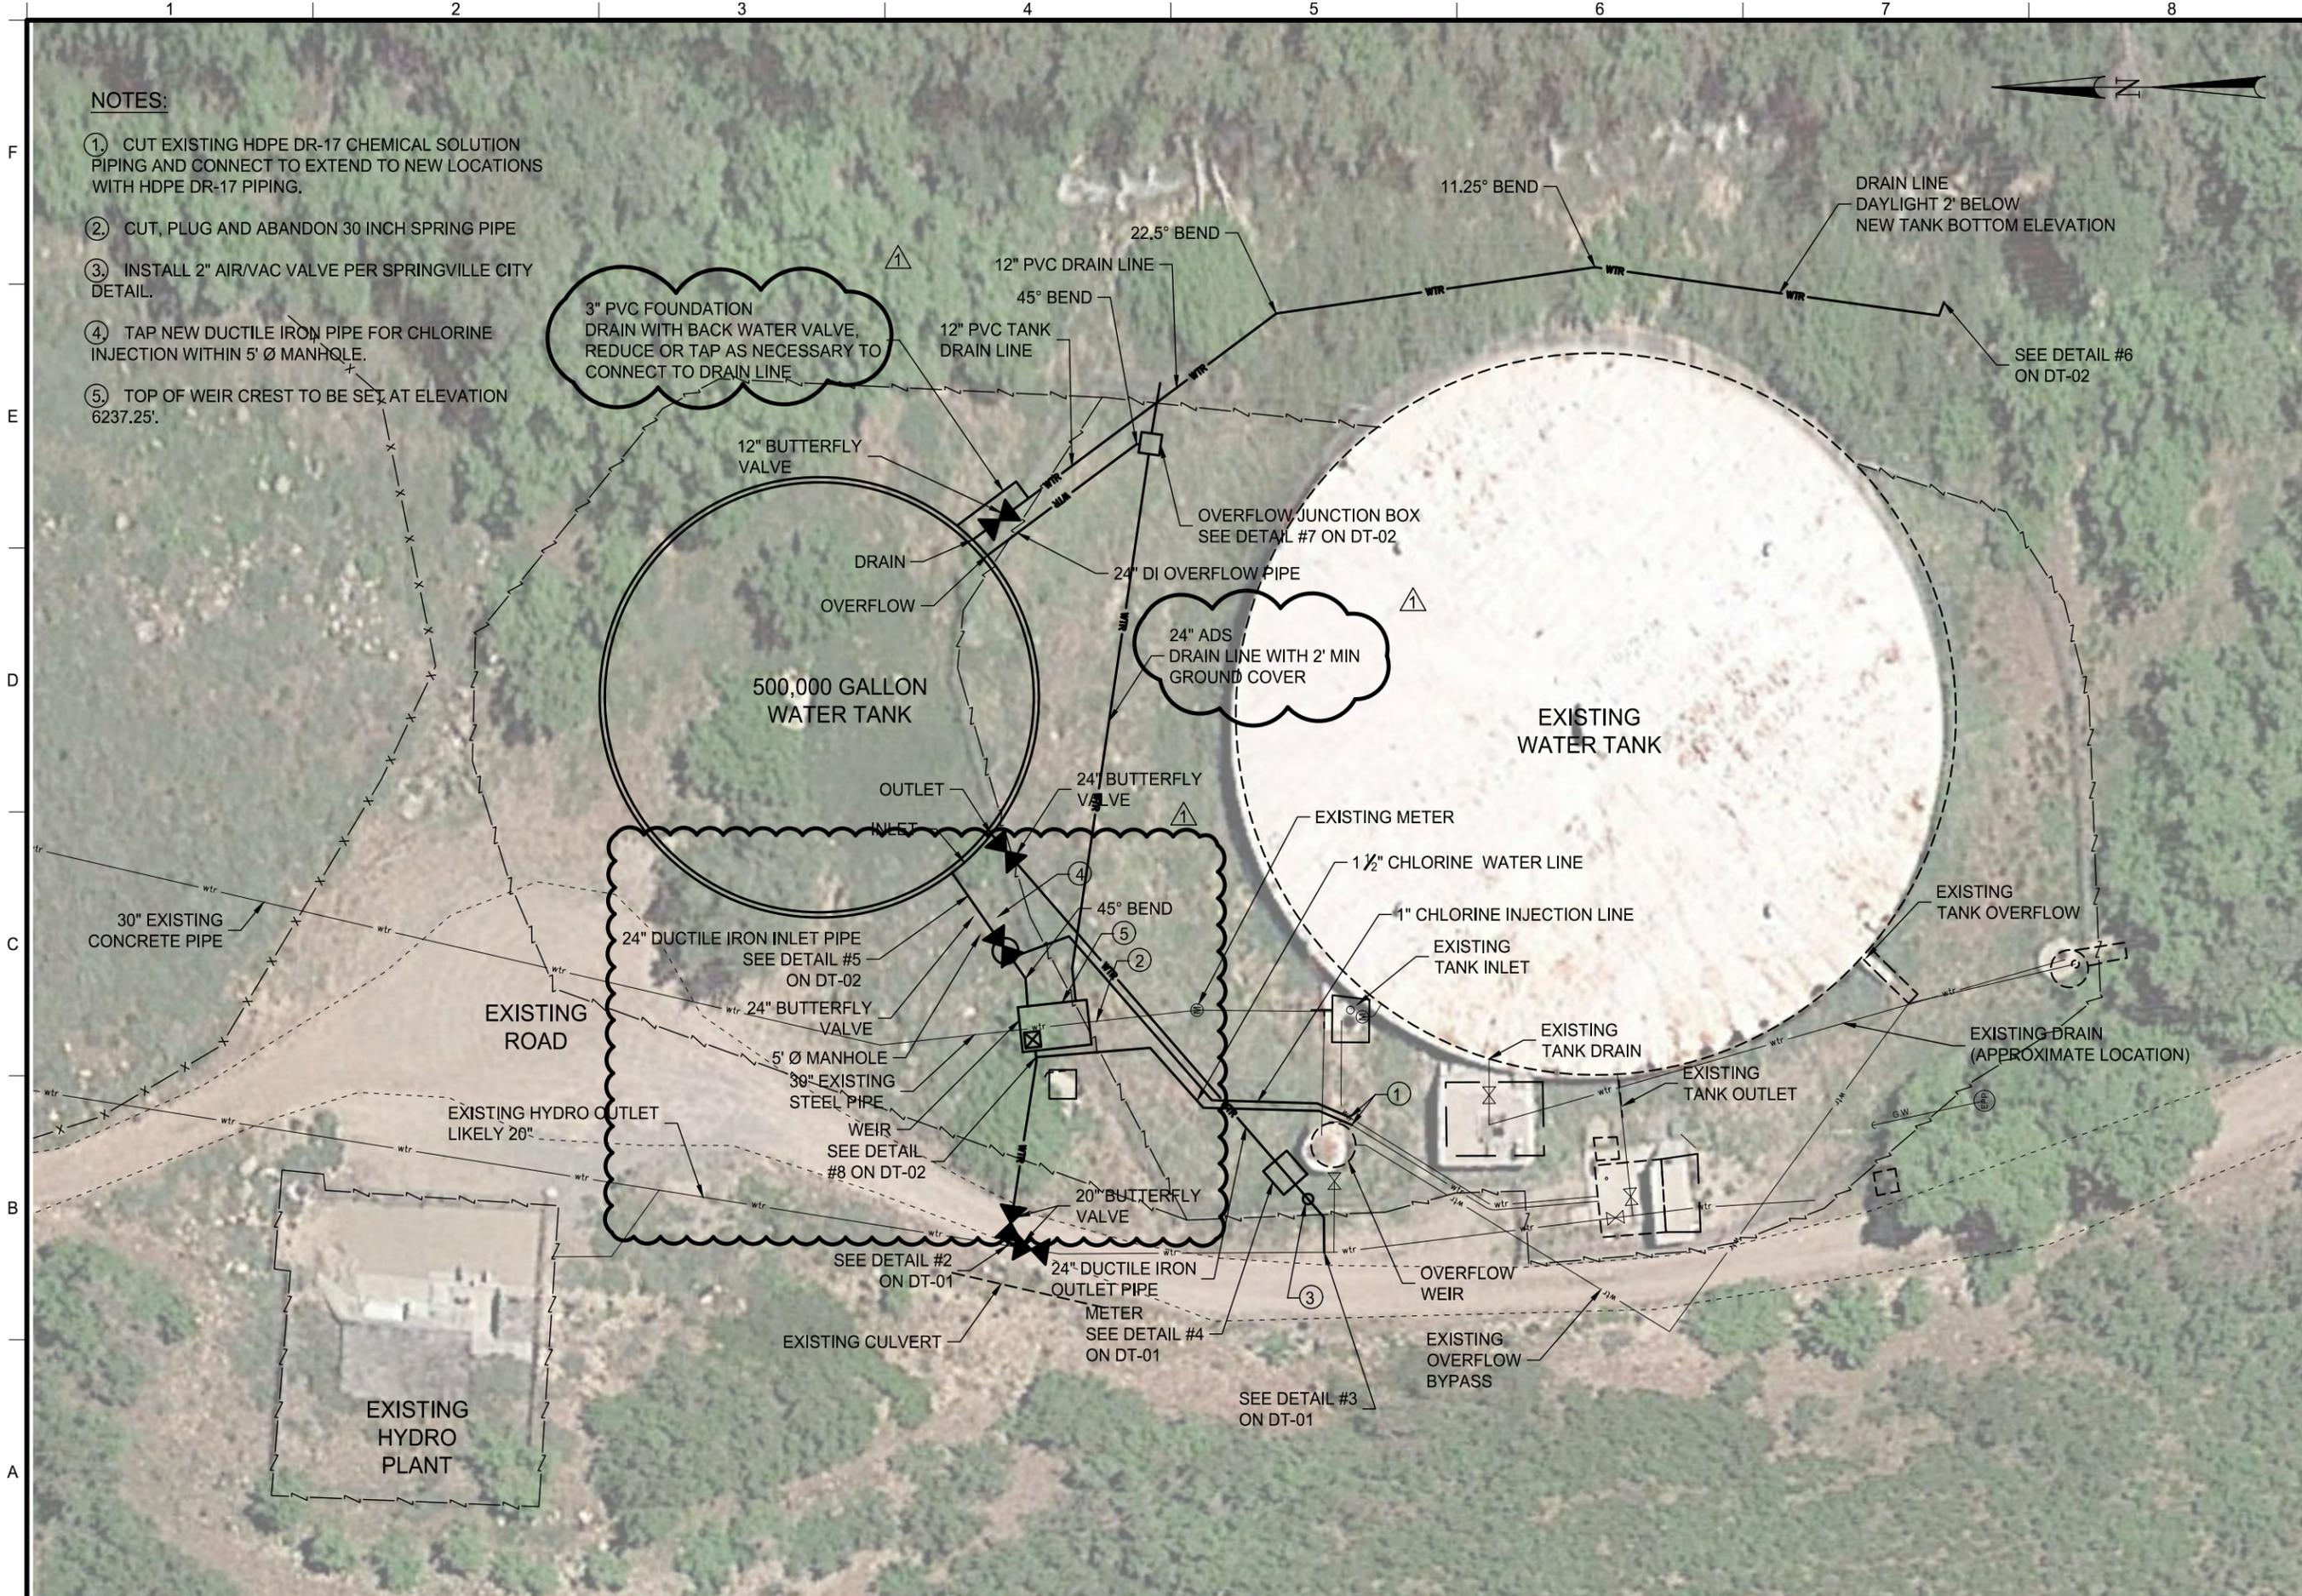

1	2	3	4	5	6	7	8						
F													
E													
D													
C													
B													
A													
<p>Jones & DeMille Engineering, Inc. CIVIL ENGINEERING - SURVEYING - TESTING GIS - ENVIRONMENTAL 1,800.748.5275 www.jonesanddemic.com</p>													
<p>APPROVAL RECORD: APPROVED: _____ DATE: _____ RECOMM: _____ DATE: _____ PROJECT DESIGN ENGINEER QUALITY MANAGEMENT REVIEW</p>													
<p>SPRINGVILLE CITY BARTHOLOMEW WATER TANK PIPING PLAN PROJECT NUMBER: 1802-207</p>													
<p>UTAH COUNTY</p>													
<p>SHEET NO. P-101</p>													
<p>REVISIONS</p> <table border="1" style="width: 100%; border-collapse: collapse;"> <tr> <th style="width: 5%;">NO.</th> <th style="width: 10%;">DATE</th> <th style="width: 85%;">REMARKS</th> </tr> <tr> <td style="text-align: center;">1</td> <td style="text-align: center;">6/7/18</td> <td>ADDENDUM 2</td> </tr> </table>								NO.	DATE	REMARKS	1	6/7/18	ADDENDUM 2
NO.	DATE	REMARKS											
1	6/7/18	ADDENDUM 2											
<p>SCALE: 1" = 30'</p>													
<p>DWG NAME: H:\JUD\Proj\1802-207\dwg\PP1-01.dwg</p>													
<p>UPDATED: 6/7/2018 PLOTTED: 6/7/2018</p>													

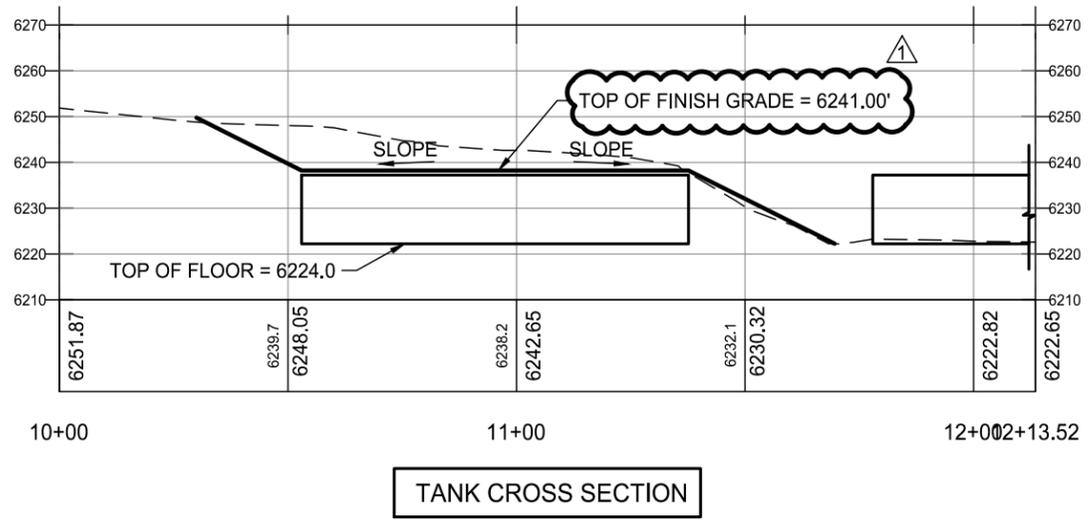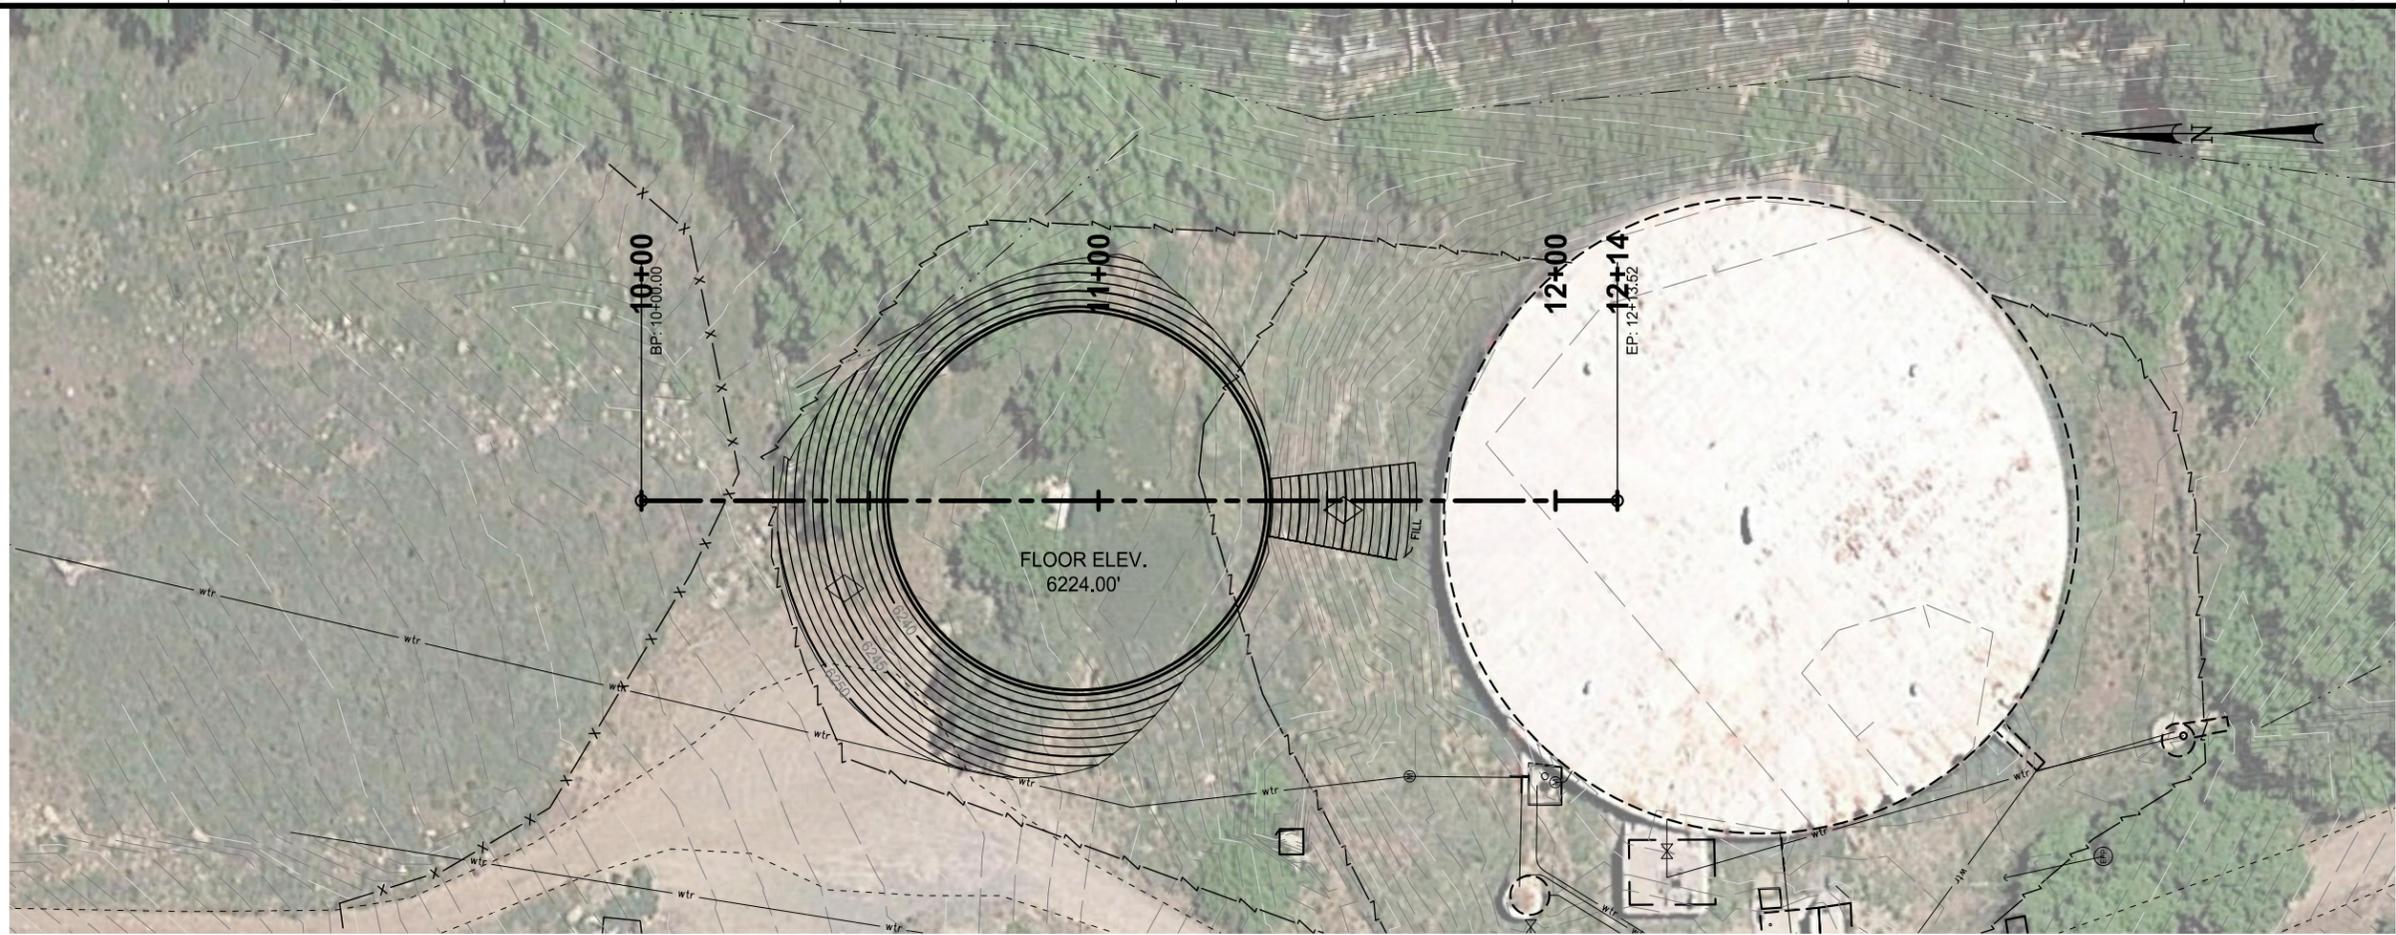

TANK CROSS SECTION

Jones & DeMille Engineering, Inc.
 CIVIL ENGINEERING - SURVEYING - TESTING
 GIS - ENVIRONMENTAL
 1.800.748.5275 www.jonesanddemic.com

SPRINGVILLE CITY
 BARTHOLOMEW WATER TANK

TANK CROSS SECTION
 PROJECT NUMBER:
 1802-207

UTAH
 COUNTY

SHEET NO. C-301

NO.	DATE	REVISIONS
1	6/7/18	ADDENDUM 2

SCALE: 1" = 40'

DWG NAME: H:\JD\Proj\1802-207.dwg XS-01.dwg


PROJECT DESIGN ENGINEER: _____ DATE: _____

QUALITY MANAGEMENT REVIEW: _____ DATE: _____


APPROVAL RECOMM: _____

APPROVED: _____


UPDATED: 6/7/2018
 PLOTTED: 6/7/2018

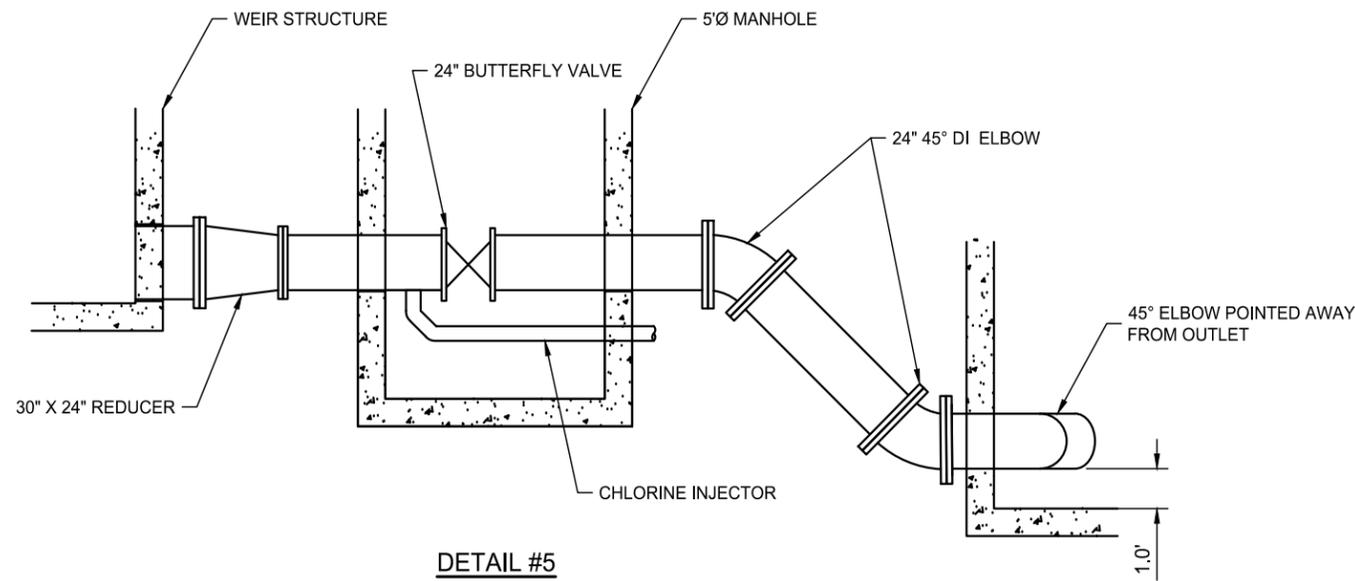


**DETAIL #5
INLET DETAIL**

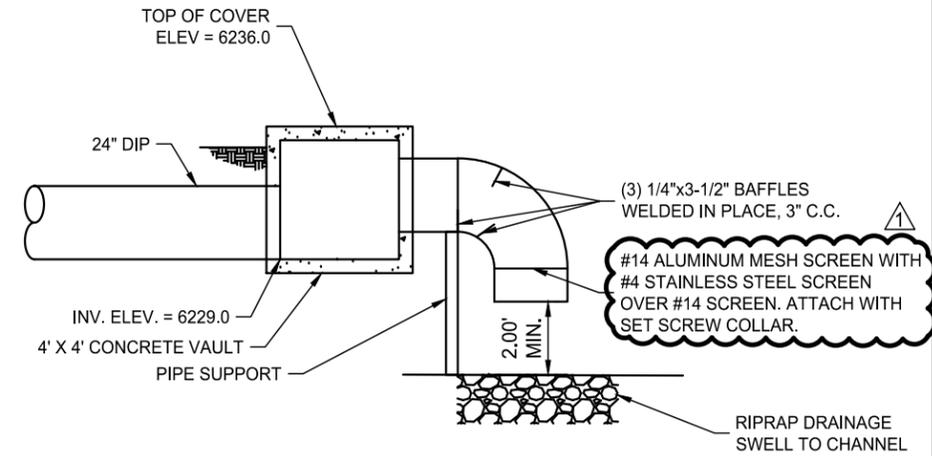

**DETAIL #7
OVERFLOW JUNCTION BOX**

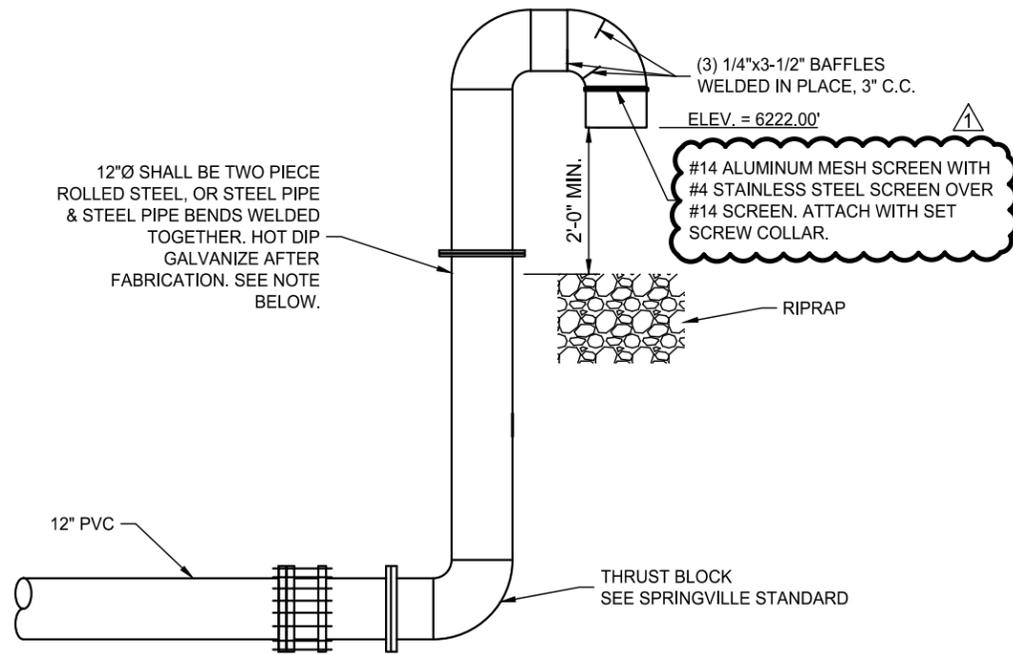


**DETAIL #6
DRAIN OUTLET DETAIL**

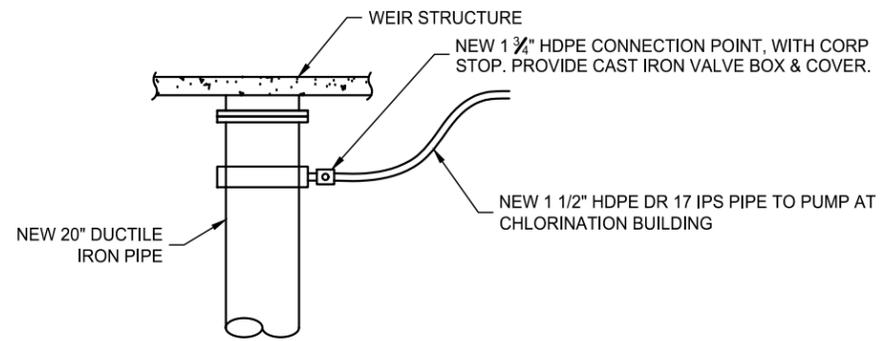

**DETAIL #8
CHLORINE WATERLINE DETAIL**


1 6/7/18 NO. DATE		ADDENDUM 2 NO. DATE		REVISIONS NO. DATE 1 6/7/2018 2 6/7/2018	
PROJECT: DESIGN ENGINEER		DWG NAME: H:\JD\Proj\1802-207\dwg\DT-01.dwg		UPDATED: 6/7/2018 PLOTTED: 6/7/2018	
APPROVAL RECOMM:		APPROVED		SCALE: 1" = 5' PROJECT NUMBER: 1802-207	
SPRINGVILLE CITY BARTHOLOMEW WATER TANK		DETAIL SHEET		PROJECT NUMBER: 1802-207	
UTAH COUNTY		SHEET NO. DT-02		PROJECT: DESIGN ENGINEER DATE:	

Jones & DeMille Engineering, Inc.
 CIVIL ENGINEERING - SURVEYING - TESTING
 GIS - ENVIRONMENTAL
 1.800.748.5275 www.jonesandmille.com

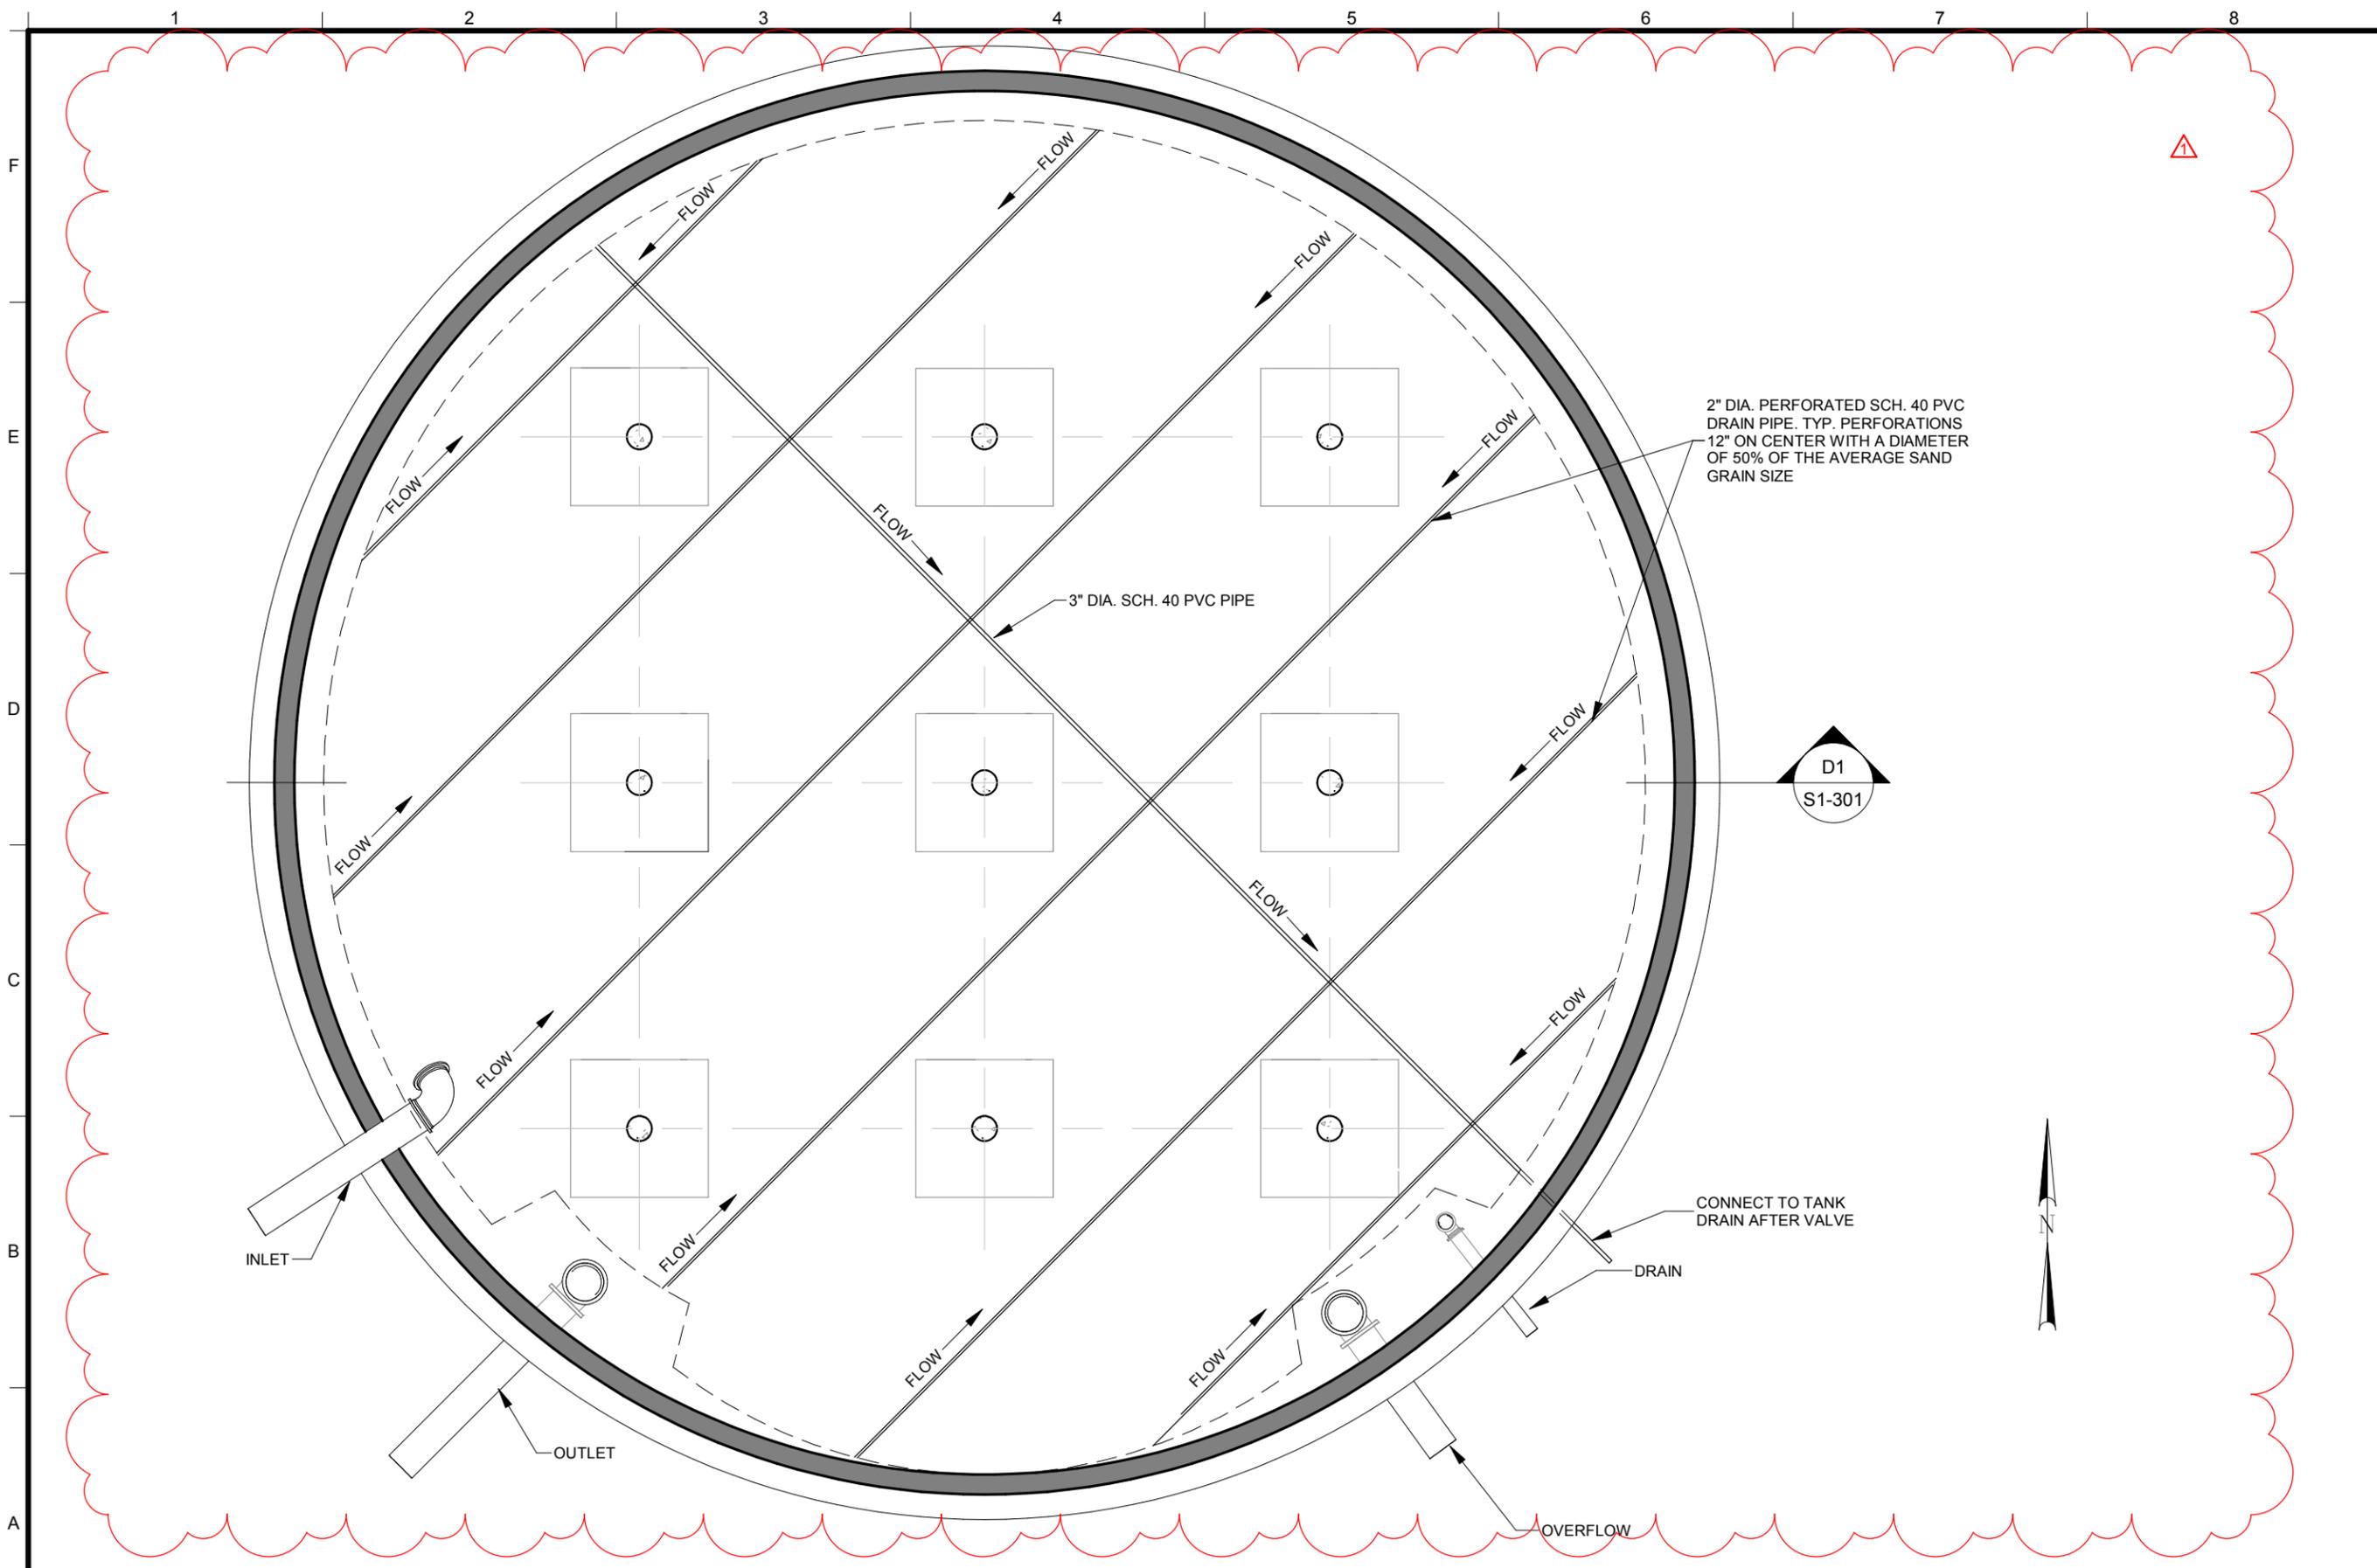

1	FIELD DRAIN PLAN	
3/32" = 1'-0"		

	Jones & DeMille Engineering, Inc. CIVIL ENGINEERING - SURVEYING - TESTING GIS - ENVIRONMENTAL 1.800.748.5275 www.jonesanddemille.com	PROJECT DESIGN ENGINEER DATE: _____ APPROVED DATE: _____	REVISIONS NO. DATE 1 6/7/18 Addendum 2 REMARKS
SPRINGVILLE CITY WATER STORAGE TANK FIELD DRAIN PLAN		PROJECT NUMBER: 1802-207	
UTAH COUNTY		SHEET NO. S1-102	
		DWG NAME: C:\Users\UC1015\Documents\SPRINGVILLE-WATER SCALE: 3/32" = 1'-0" DATE: _____ UPDATED: 6/7/2018 2:34:57 PM	

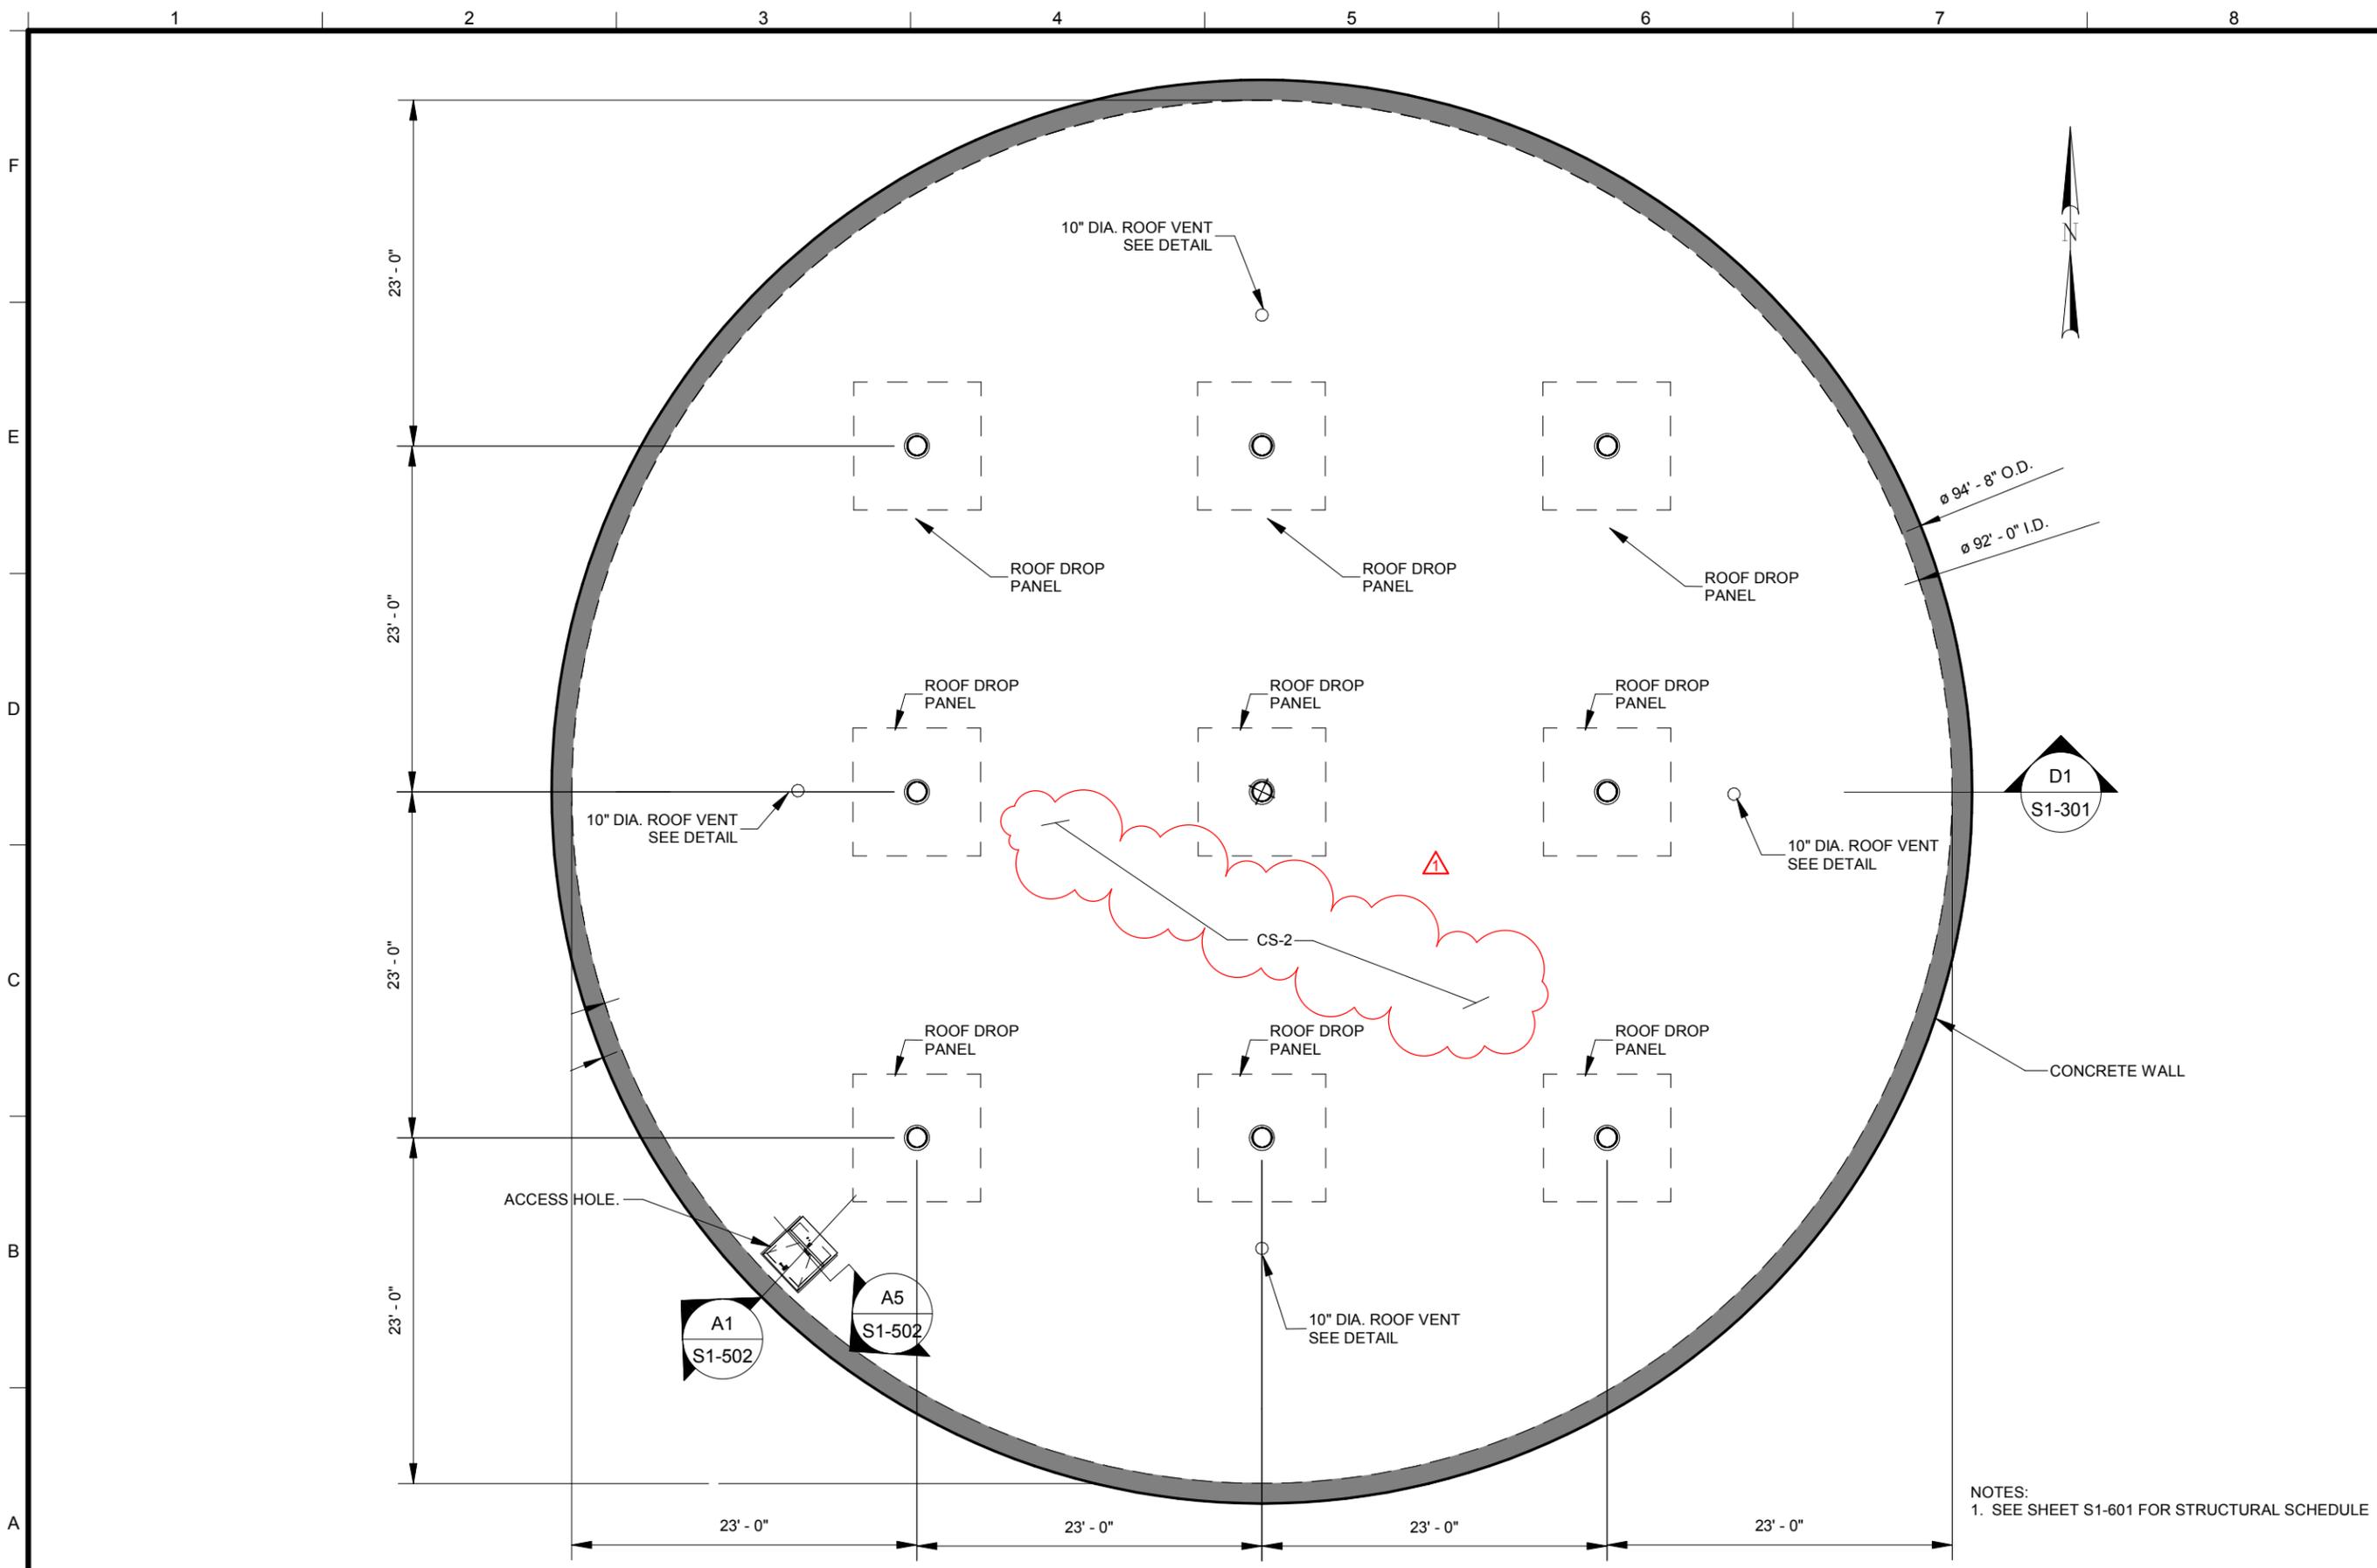

NOTES:
1. SEE SHEET S1-601 FOR STRUCTURAL SCHEDULE

REVISIONS	
NO.	DATE
1	07/18
Addendum 2	
REMARKS	
DWG NAME: C:\Users\UC1015\Documents\SPRINGVILLE-WATER	
SCALE: 3/32" = 1'-0"	
UPDATED: 07/2018 1:46:19 PM	

Jones & DeMille Engineering, Inc.
 CIVIL ENGINEERING - SURVEYING - TESTING
 GIS - ENVIRONMENTAL
 1.800.748.5275 www.jonesandmille.com


APPROVAL: [Signature]
 RECOMM: [Signature]
 APPROVED: [Signature]

PROJECT DESIGN ENGINEER: [Signature]
 QUALITY MANAGEMENT REVIEW: [Signature]

SPRINGVILLE CITY	PROJECT NUMBER: 1802-207
WATER STORAGE TANK	
ROOF PLAN	


A1 ROOF PLAN
3/32" = 1'-0"

- NOTE:**
1. CAST-IN-PLACE ROOF SHOWN
 2. REINFORCING STEEL NOT SHOWN
 3. COORDINATE W/ SITE PLAN FOR FINISHED GRADE

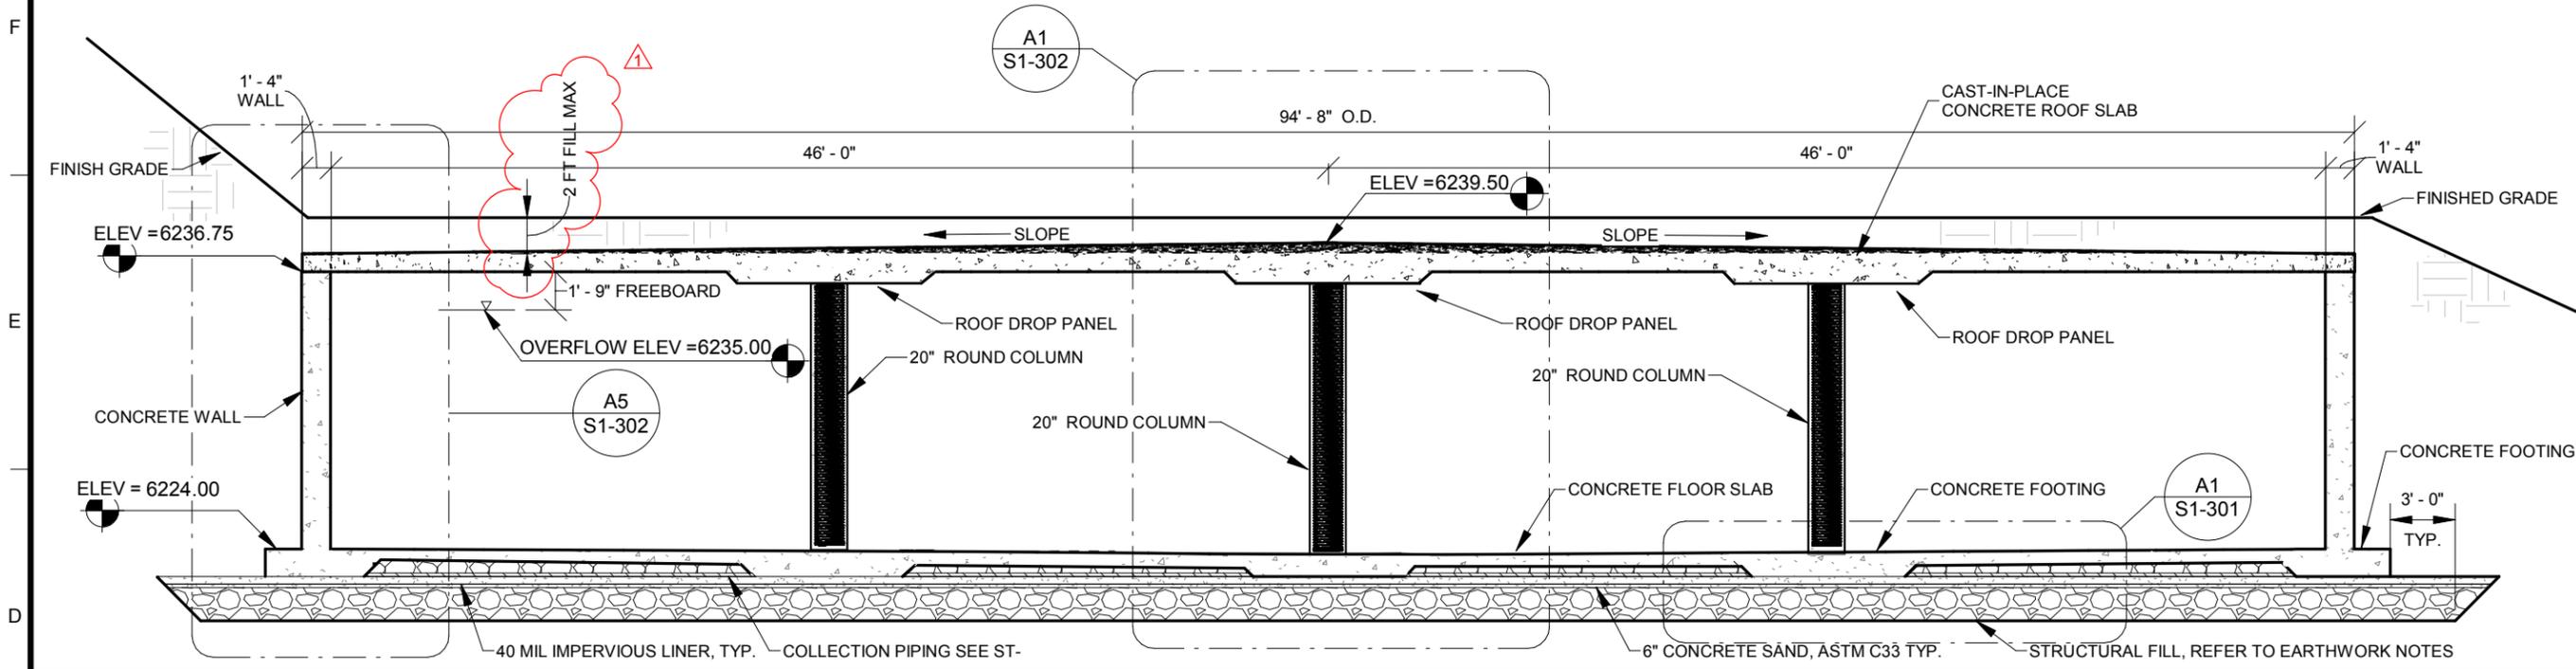

D1 TANK CROSS SECTION

1/8" = 1'-0"


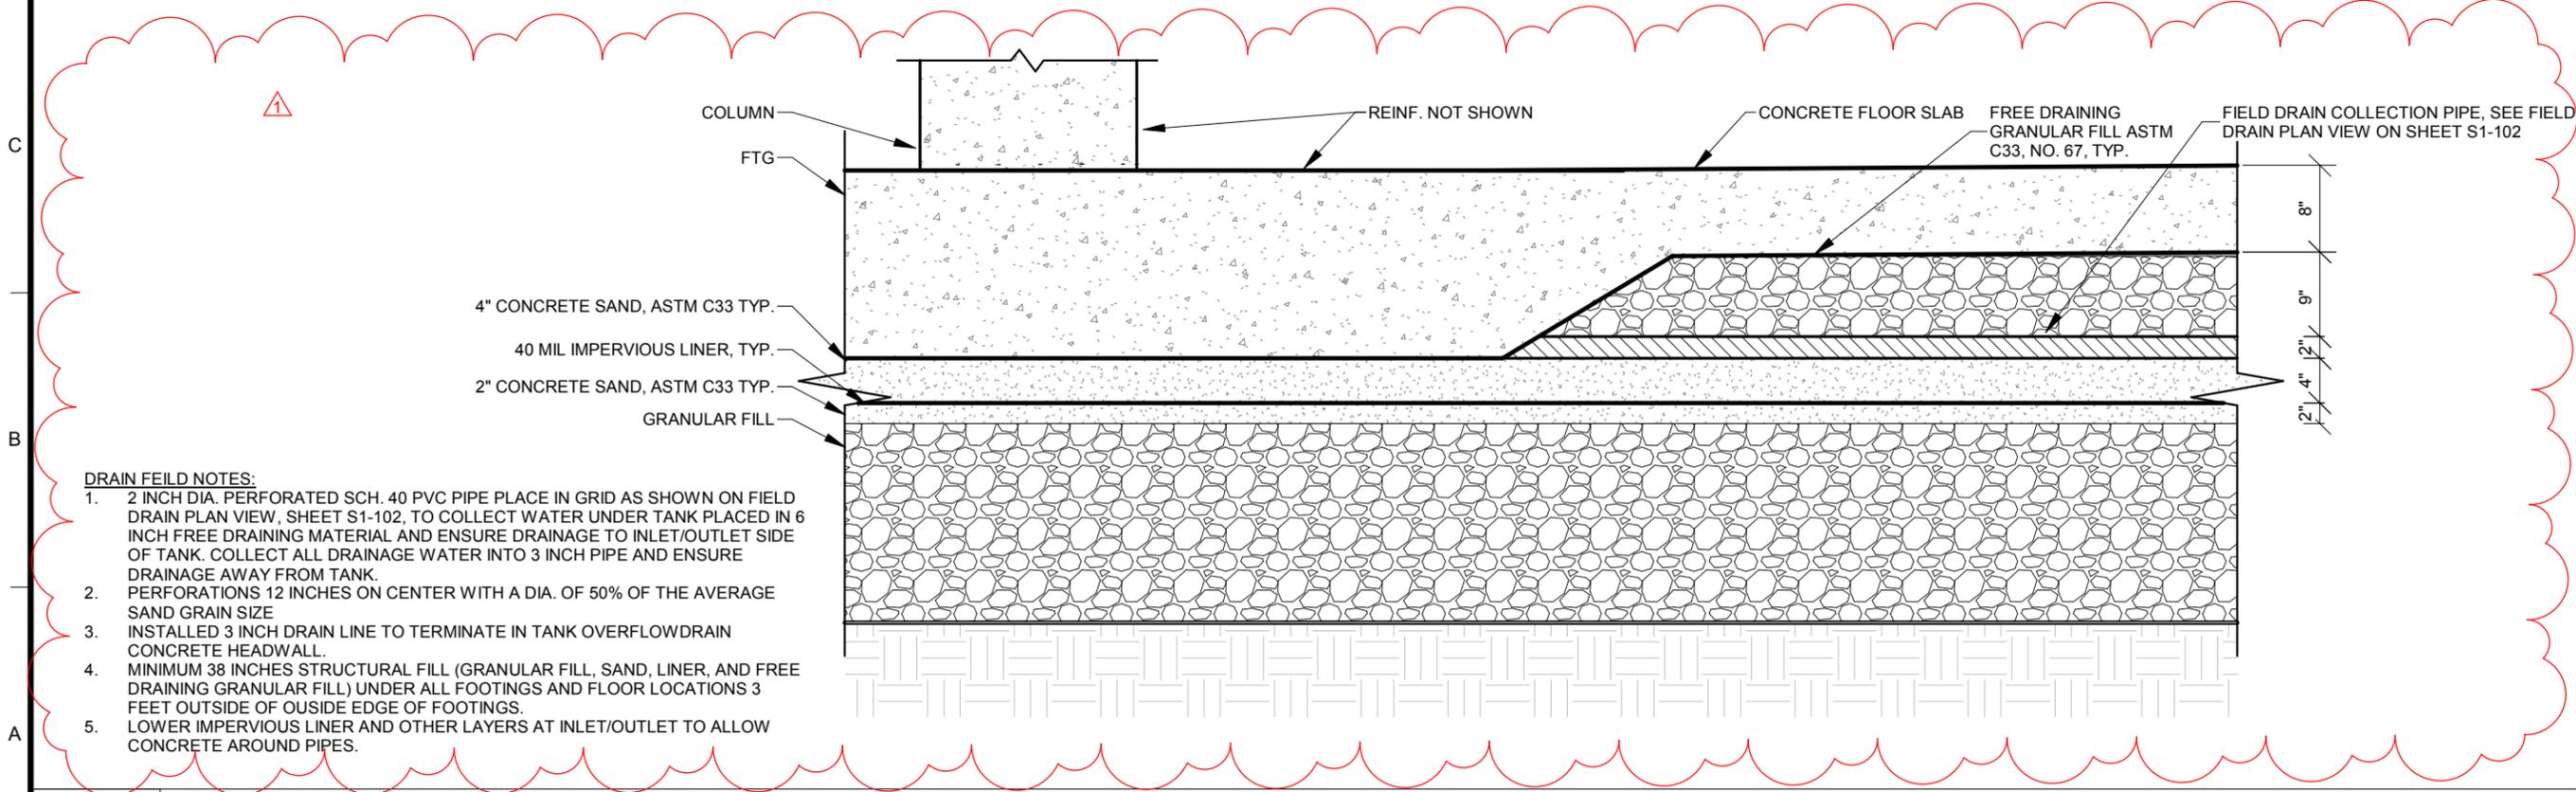


- DRAIN FEILD NOTES:**
1. 2 INCH DIA. PERFORATED SCH. 40 PVC PIPE PLACE IN GRID AS SHOWN ON FIELD DRAIN PLAN VIEW, SHEET S1-102, TO COLLECT WATER UNDER TANK PLACED IN 6 INCH FREE DRAINING MATERIAL AND ENSURE DRAINAGE TO INLET/OUTLET SIDE OF TANK. COLLECT ALL DRAINAGE WATER INTO 3 INCH PIPE AND ENSURE DRAINAGE AWAY FROM TANK.
 2. PERFORATIONS 12 INCHES ON CENTER WITH A DIA. OF 50% OF THE AVERAGE SAND GRAIN SIZE
 3. INSTALLED 3 INCH DRAIN LINE TO TERMINATE IN TANK OVERFLOW DRAIN CONCRETE HEADWALL.
 4. MINIMUM 38 INCHES STRUCTURAL FILL (GRANULAR FILL, SAND, LINER, AND FREE DRAINING GRANULAR FILL) UNDER ALL FOOTINGS AND FLOOR LOCATIONS 3 FEET OUTSIDE OF OUSIDE EDGE OF FOOTINGS.
 5. LOWER IMPERVIOUS LINER AND OTHER LAYERS AT INLET/OUTLET TO ALLOW CONCRETE AROUND PIPES.

A1 TANK STRUCTURAL FILL SECTION



NTS

<p>UTAH COUNTY</p> <p>SHEET NO. S1-301</p>		<p>PROJECT NUMBER: 1802-207</p>	<p>WATER STORAGE TANK</p> <p>TANK CROSS SECTION</p>	<p>SPRINGVILLE CITY</p>
<p>APPROVAL RECOMM: APPROVED</p>		<p>Jones & DeMille Engineering, Inc. CIVIL ENGINEERING - SURVEYING - TESTING GIS - ENVIRONMENTAL 1.800.748.5275 www.jonesandmille.com</p>		
<p>DATE: _____</p>	<p>DATE: _____</p>	<p>DATE: _____</p>	<p>DATE: _____</p>	<p>DATE: _____</p>
<p>PROJECT DESIGN ENGINEER</p>	<p>QUALITY MANAGEMENT REVIEW</p>	<p>REVISIONS</p>	<p>REMARKS</p>	<p>REVISIONS</p>
<p>NO. 1</p>	<p>DATE</p>	<p>DATE</p>	<p>DATE</p>	<p>DATE</p>
<p>67718</p>	<p>ADDENDUM 2</p>	<p>AS INDICATED</p>	<p>AS INDICATED</p>	<p>AS INDICATED</p>
<p>6/7/2018</p>	<p>1:46:22 PM</p>	<p>9/7/2018</p>	<p>1:46:22 PM</p>	<p>9/7/2018</p>
<p>1:46:22 PM</p>	<p>1:46:22 PM</p>	<p>1:46:22 PM</p>	<p>1:46:22 PM</p>	<p>1:46:22 PM</p>

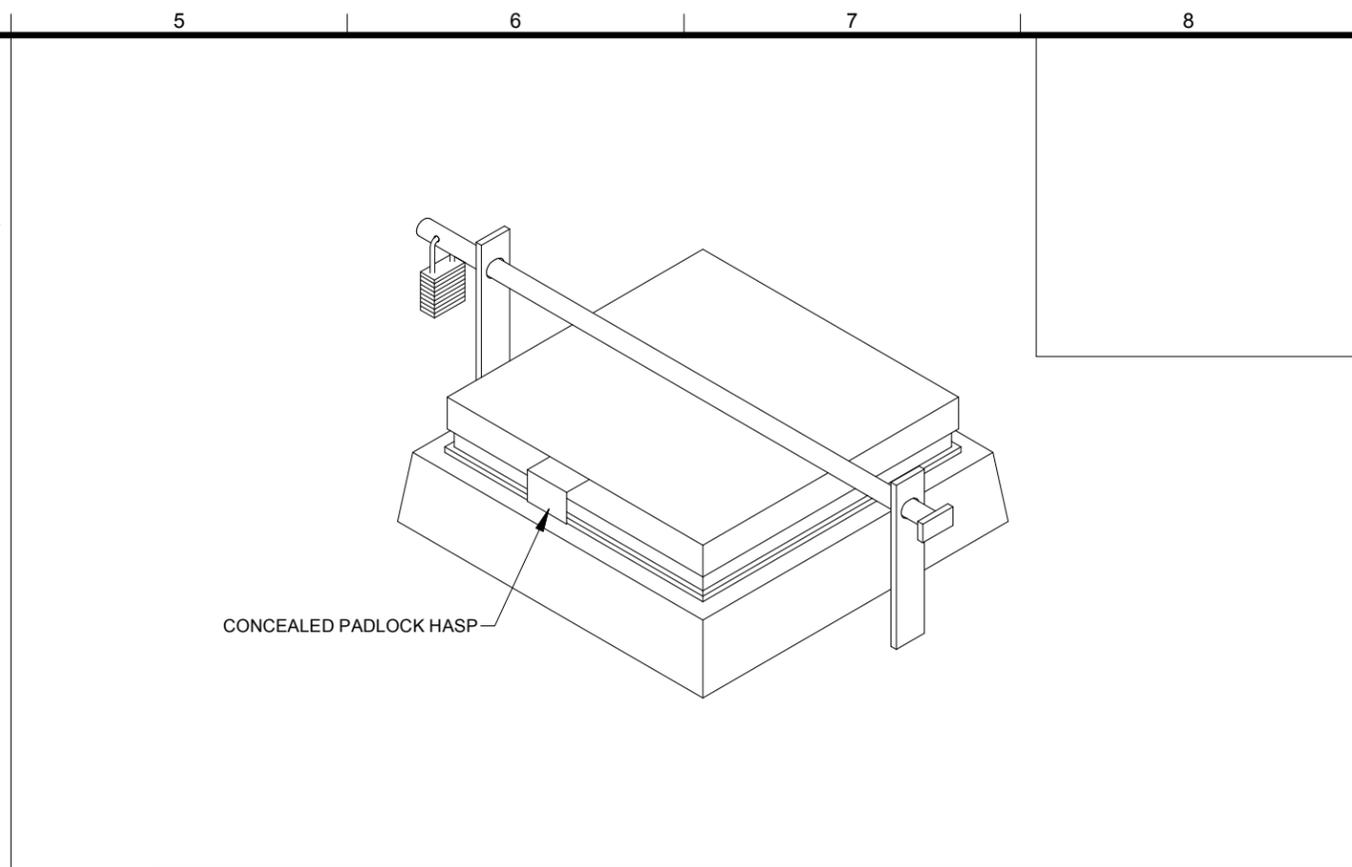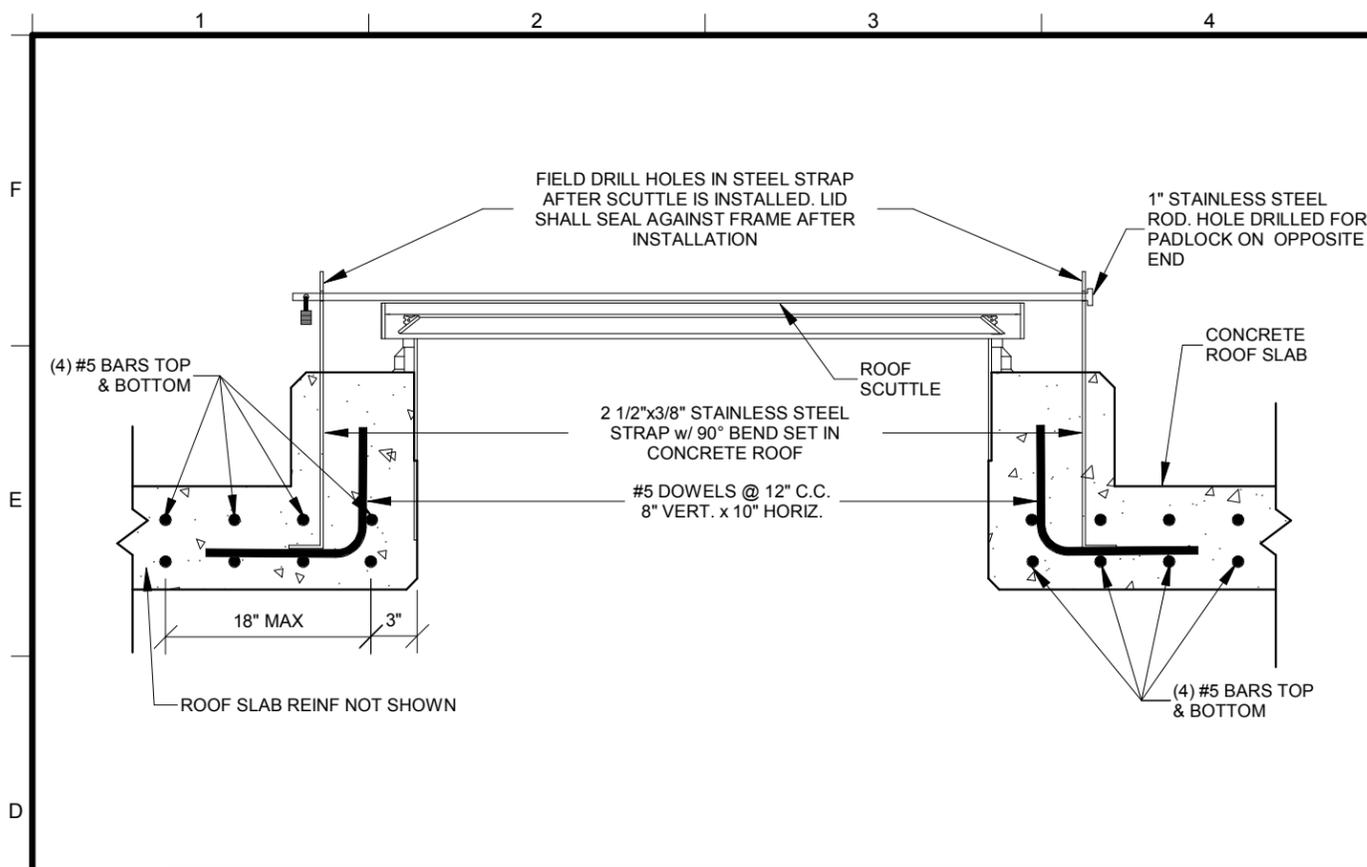

D1 ACCESS HOLE SECTION
1" = 1'-0"

D5 ACCESS HOLE 3D VIEW
1" = 1'-0"

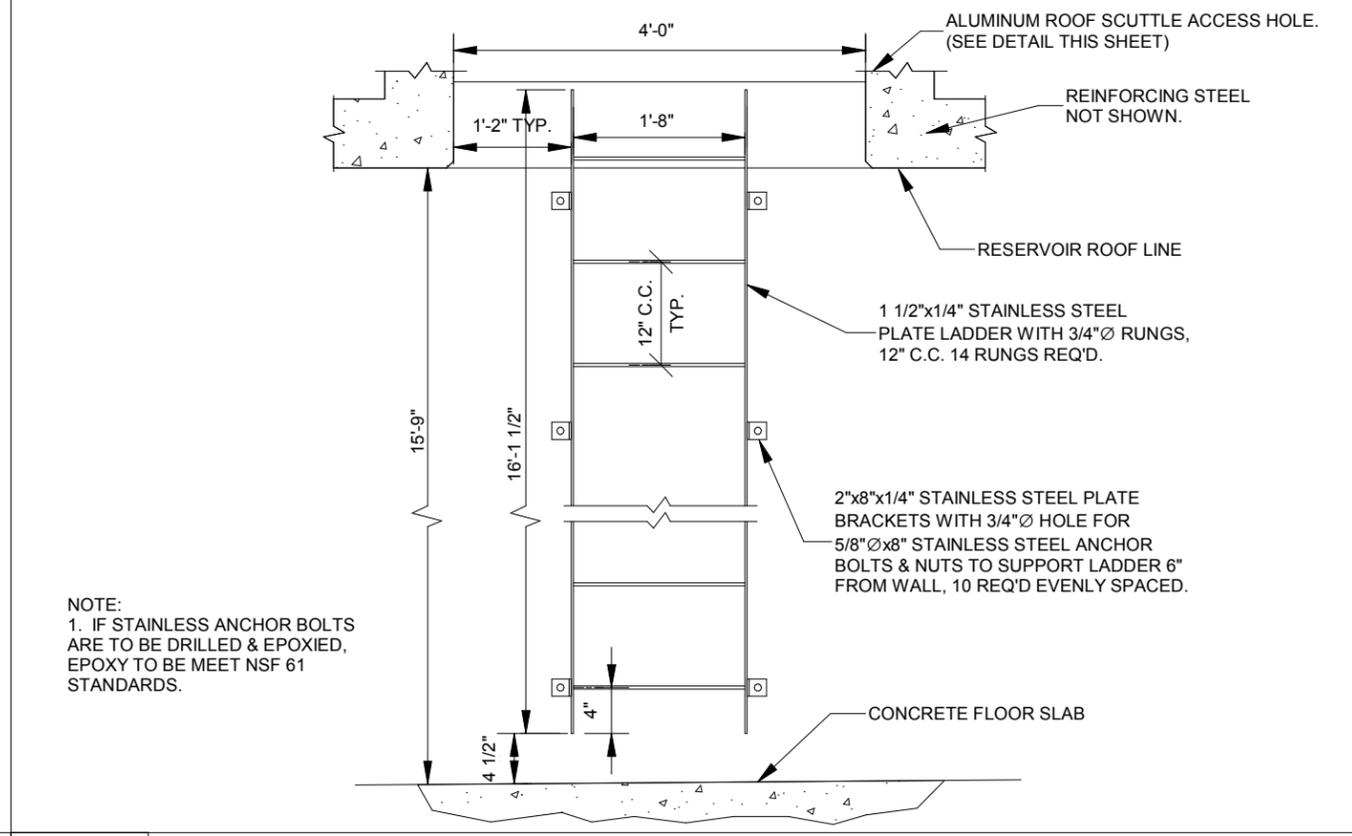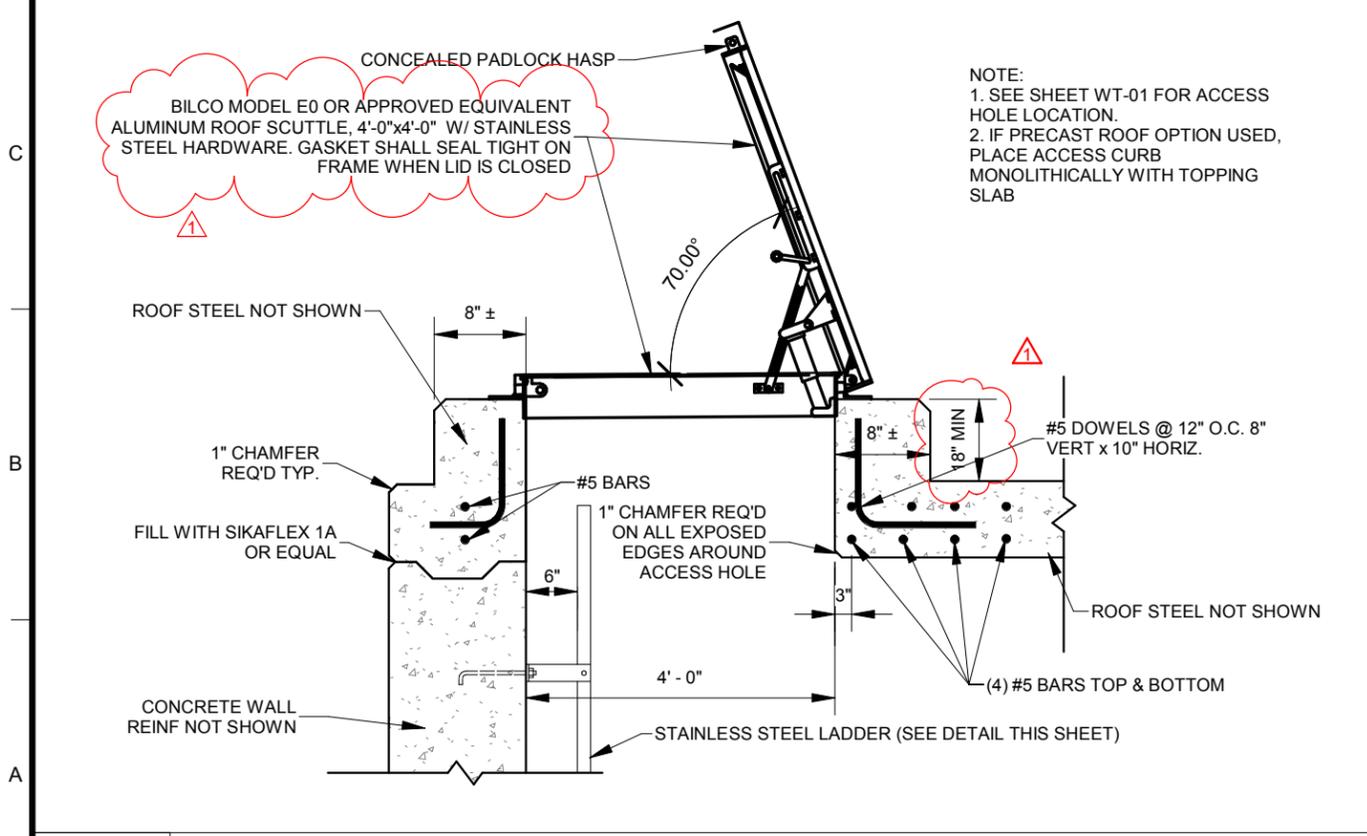


A1 ACCESS HOLE DETAIL
3/4" = 1'-0"

A5 LADDER
3/4" = 1'-0"

PROJECT NO. 1802-207 PROJECT NUMBER: 1802-207		SPRINGVILLE CITY WATER STORAGE TANK TANK DETAILS		UTAH COUNTY		SHEET NO. S1-502	
APPROVAL RECOMM: [Signature] APPROVED: [Signature]		PROJECT DESIGN ENGINEER: [Signature] DATE:		QUALITY MANAGEMENT REVIEW: [Signature] DATE:		JONES & DeMille Engineering, Inc. CIVIL ENGINEERING - SURVEYING - TESTING GIS - ENVIRONMENTAL 1.800.748.5275 www.jonesandmille.com	
1 07/18 Addendum 2 NO. DATE		REMARKS		REVISIONS		DWG NAME: As indicated C:\Users\UC1015\Documents\SPRINGVILLE-WATER 07/2018 1:46:23 PM UPDATED:	

CONCRETE COLUMN SCHEDULE

MARK	COUNT	SIZE	VERT REINF	TIES	REMARKS
CC-1	9	20"	(12) #6 BARS	#5 SPIRAL 2.5" PITCH	20" ROUND COLUMN

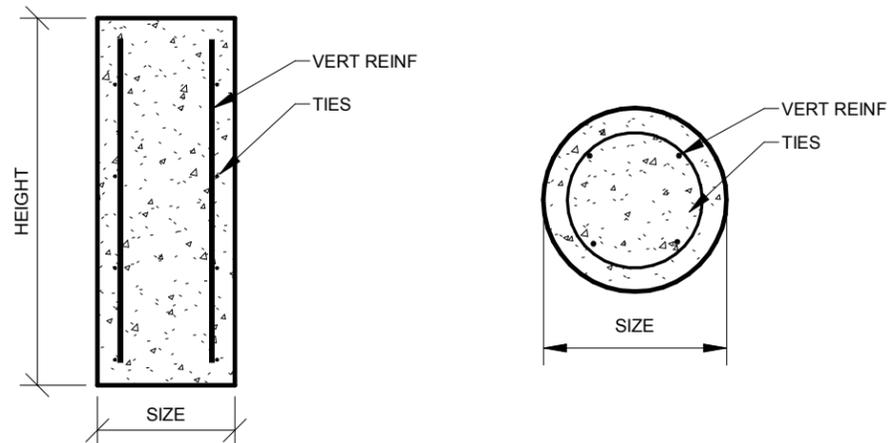


ELEVATION VIEW

PLAN VIEW

NOTES:
1. ALL VERTICAL COLUMN REINFORCING SHALL BE TERMINATED WITH STANDARD 90° HOOKS AT BOTTOM

CONCRETE SLAB SCHEDULE

MARK	THICKNESS	TYPE	REINF	TOP MAT REINF	BOT MAT REINF	REMARKS
CS-1	8"	A	#5 @ 12" OC BW	N/A	N/A	FLOOR SLAB
CS-2	9"	B	N/A	#6 @ 8" OC BW	#6 @ 8" OC BW	ROOF SLAB

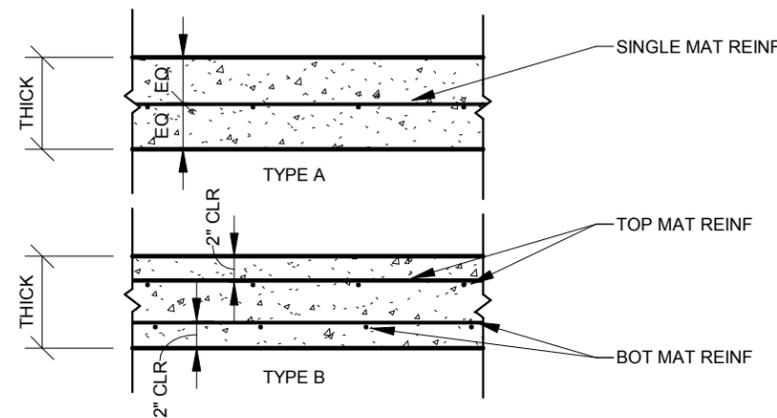


CONCRETE SLAB

NOTES:
B.W. = BOTH WAYS

CONCRETE WALL SCHEDULE

MARK	THICKNESS	HORIZ REINF	VERT REINF	TYPE	REMARKS
CW-1	1' - 4"	#6 @ 6" OC	#6 @ 8" OC	C	

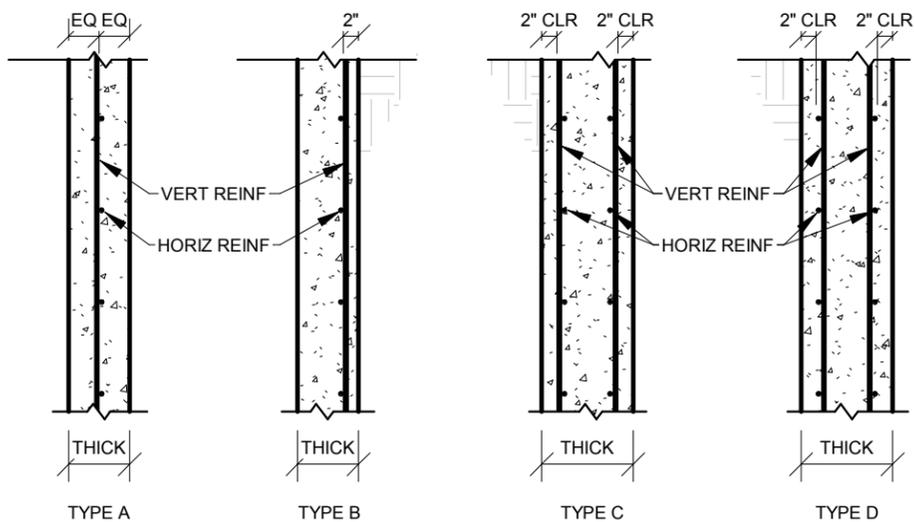


CONCRETE WALLS (SECTION VIEW)

NOTES:
E.F. = EACH FACE
O.F. = OUTSIDE FACE (AGAINST SOIL)
I.F. = INSIDE FACE

CONCRETE FOOTING SCHEDULE

MARK	WIDTH	LENGTH	THICK	LONG REINF	PERP REINF	REMARKS
CF-1	8' - 6"	8' - 6"	1' - 6"	(12) #6 BARS	(12) #6 BARS	
CF-2	3' - 6"	CONT.	1' - 6"	(5) #5 BARS	#5 @ 18" OC	

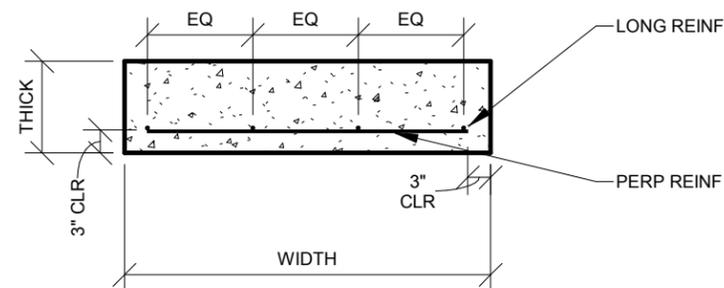



CONCRETE FOOTING

Jones & DeMille Engineering, Inc.
CIVIL ENGINEERING - SURVEYING - TESTING
GIS - ENVIRONMENTAL
1.800.748.5275 www.jonesandmille.com



SPRINGVILLE CITY
WATER STORAGE TANK
STRUCTURAL SCHEDULES
PROJECT NUMBER: 1802-207

UTAH
COUNTY
SHEET NO. S1-601

 REVISIONS
DATE: 07/2018
1:46:24 PM
UPDATED:
DWG NAME: C:\Users\UC1010\Documents\SPRINGVILLE-WATER
SCALE: As indicated
NO. 1
DATE: 07/18
Addendum 2

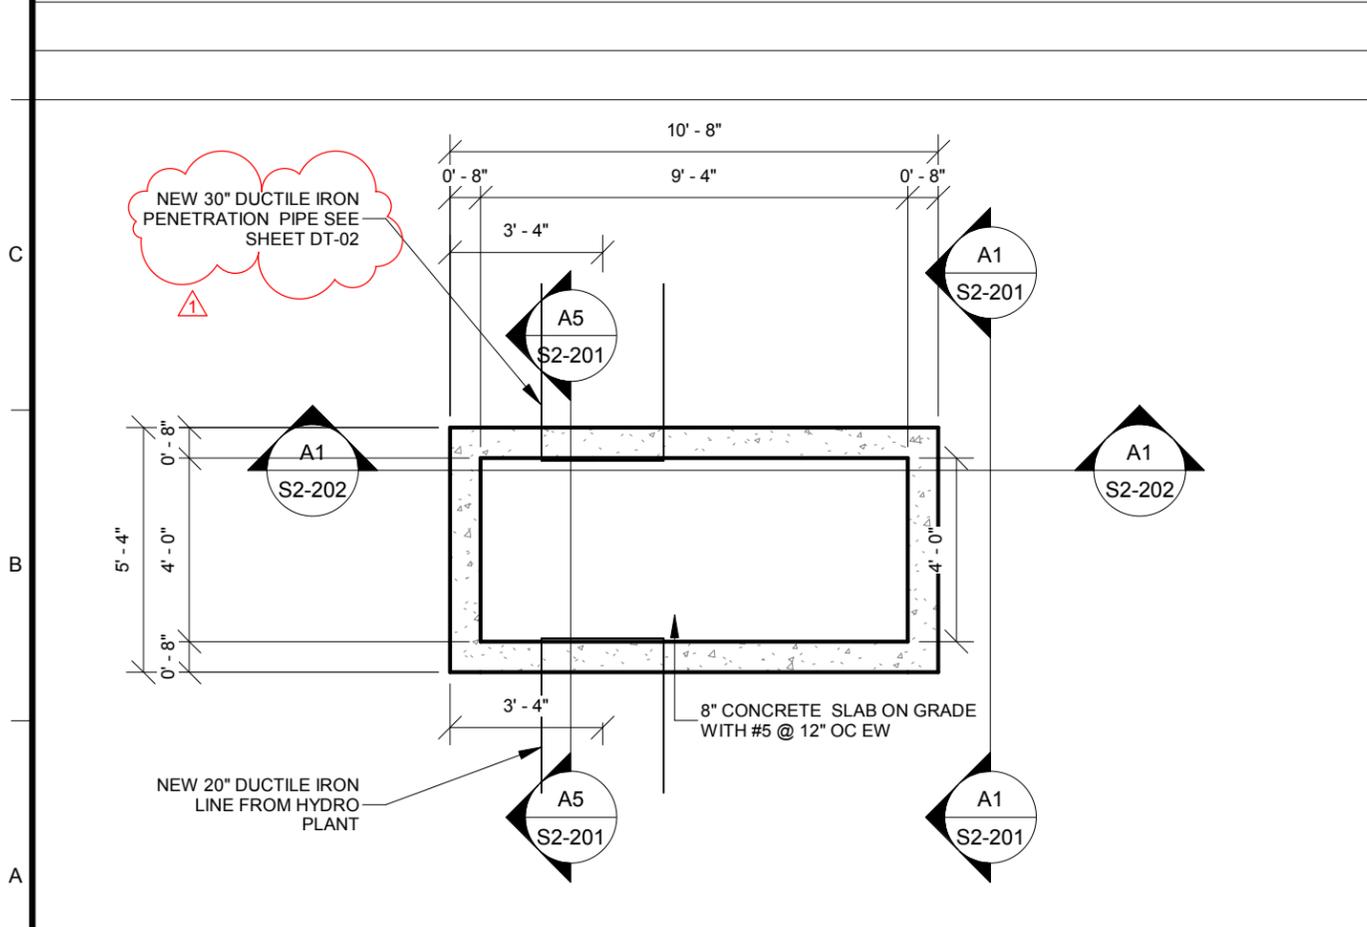


A1 FOUNDATION PLAN
1/4" = 1'-0"

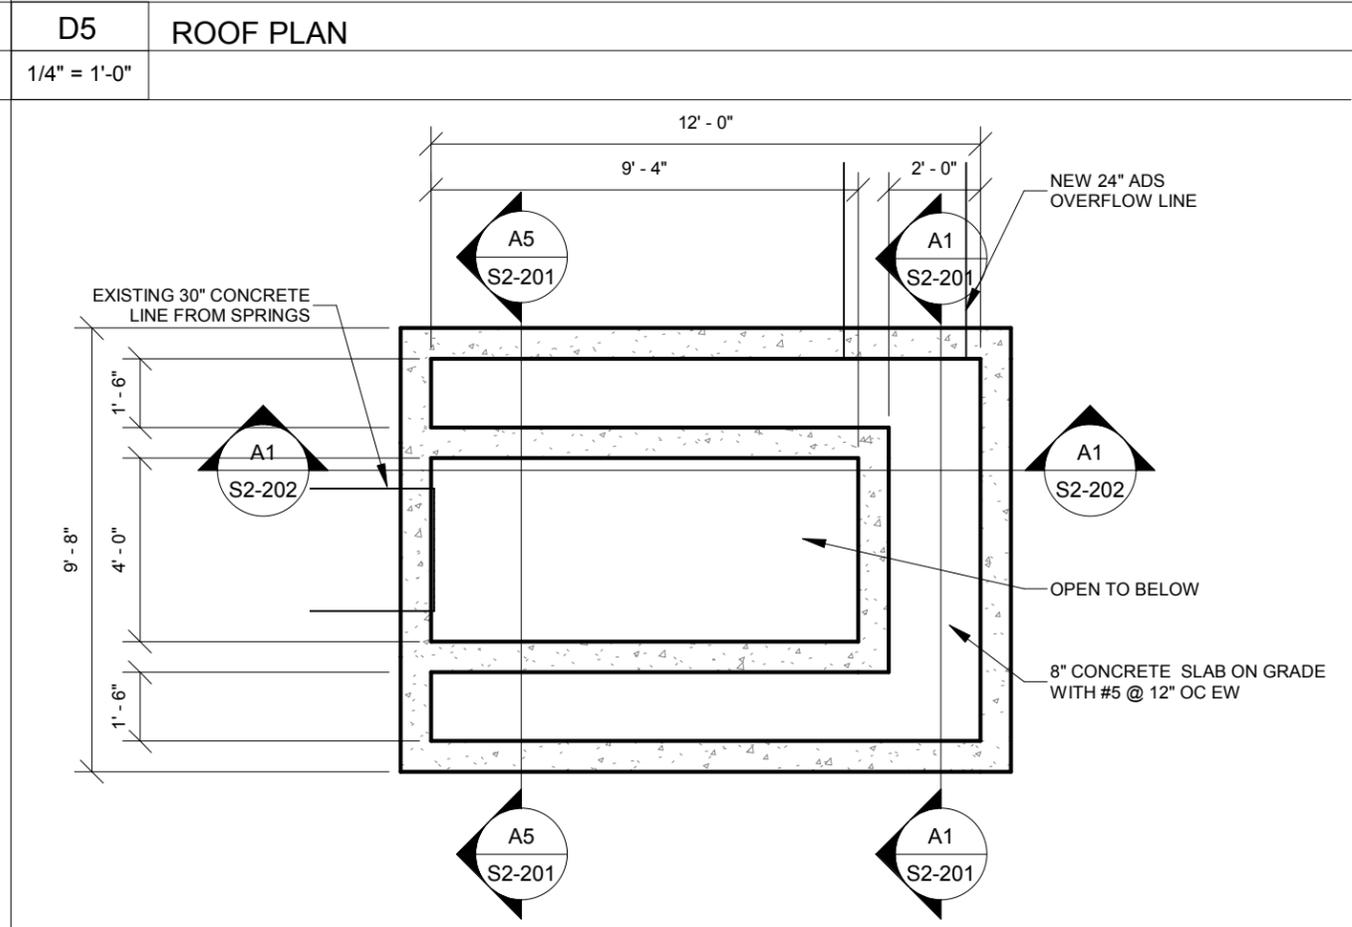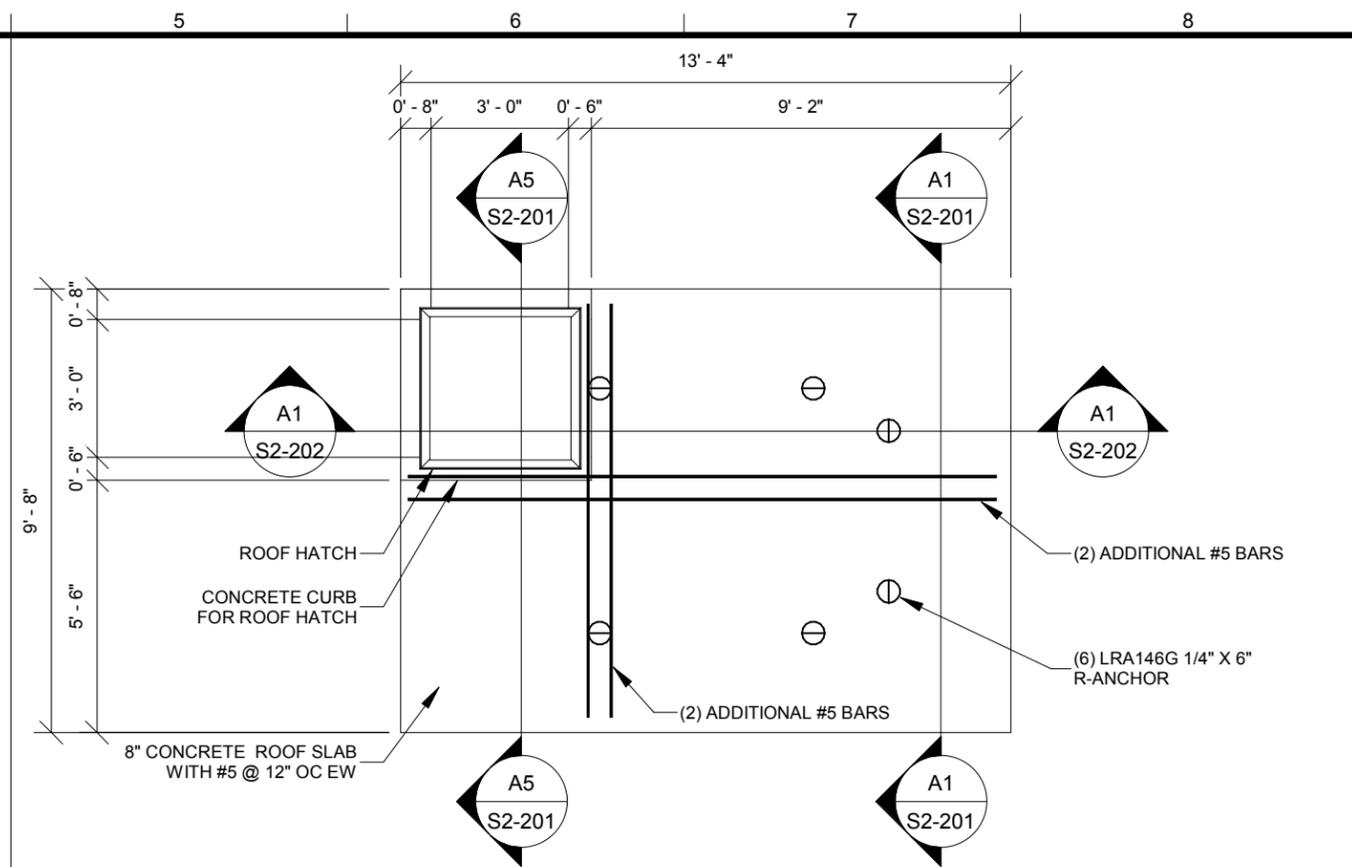

A5 OVERFLOW FLOOR
1/4" = 1'-0"

<p>67718 Addendum 2</p>		<p>REVISIONS</p>	
<p>1 07/18 DATE</p>		<p>1 07/2018 1:42:35 PM</p>	
<p>SCALE: 1/4" = 1'-0"</p>		<p>DWG NAME: H:\UD\Proj\1802-207\wgj\Revit\Overflow Weir.rvt</p>	
<p>APPROVAL RECOMM: APPROVED</p>		<p>PROJECT DESIGN ENGINEER DATE: DATE: DATE:</p>	
<p>UTAH COUNTY</p>		<p>REVISIONS</p>	
<p>SPRINGVILLE CITY</p>		<p>1802-207</p>	
<p>BARTHOLOMEW WATER TANK</p>		<p>PLAN VIEWS</p>	
<p>SHEET NO. S2-101</p>		<p>PROJECT NUMBER:</p>	





Jones & DeMille Engineering, Inc.
 CIVIL ENGINEERING - SURVEYING - TESTING
 GIS - ENVIRONMENTAL
 1.800.748.5275 www.jonesanddemic.com

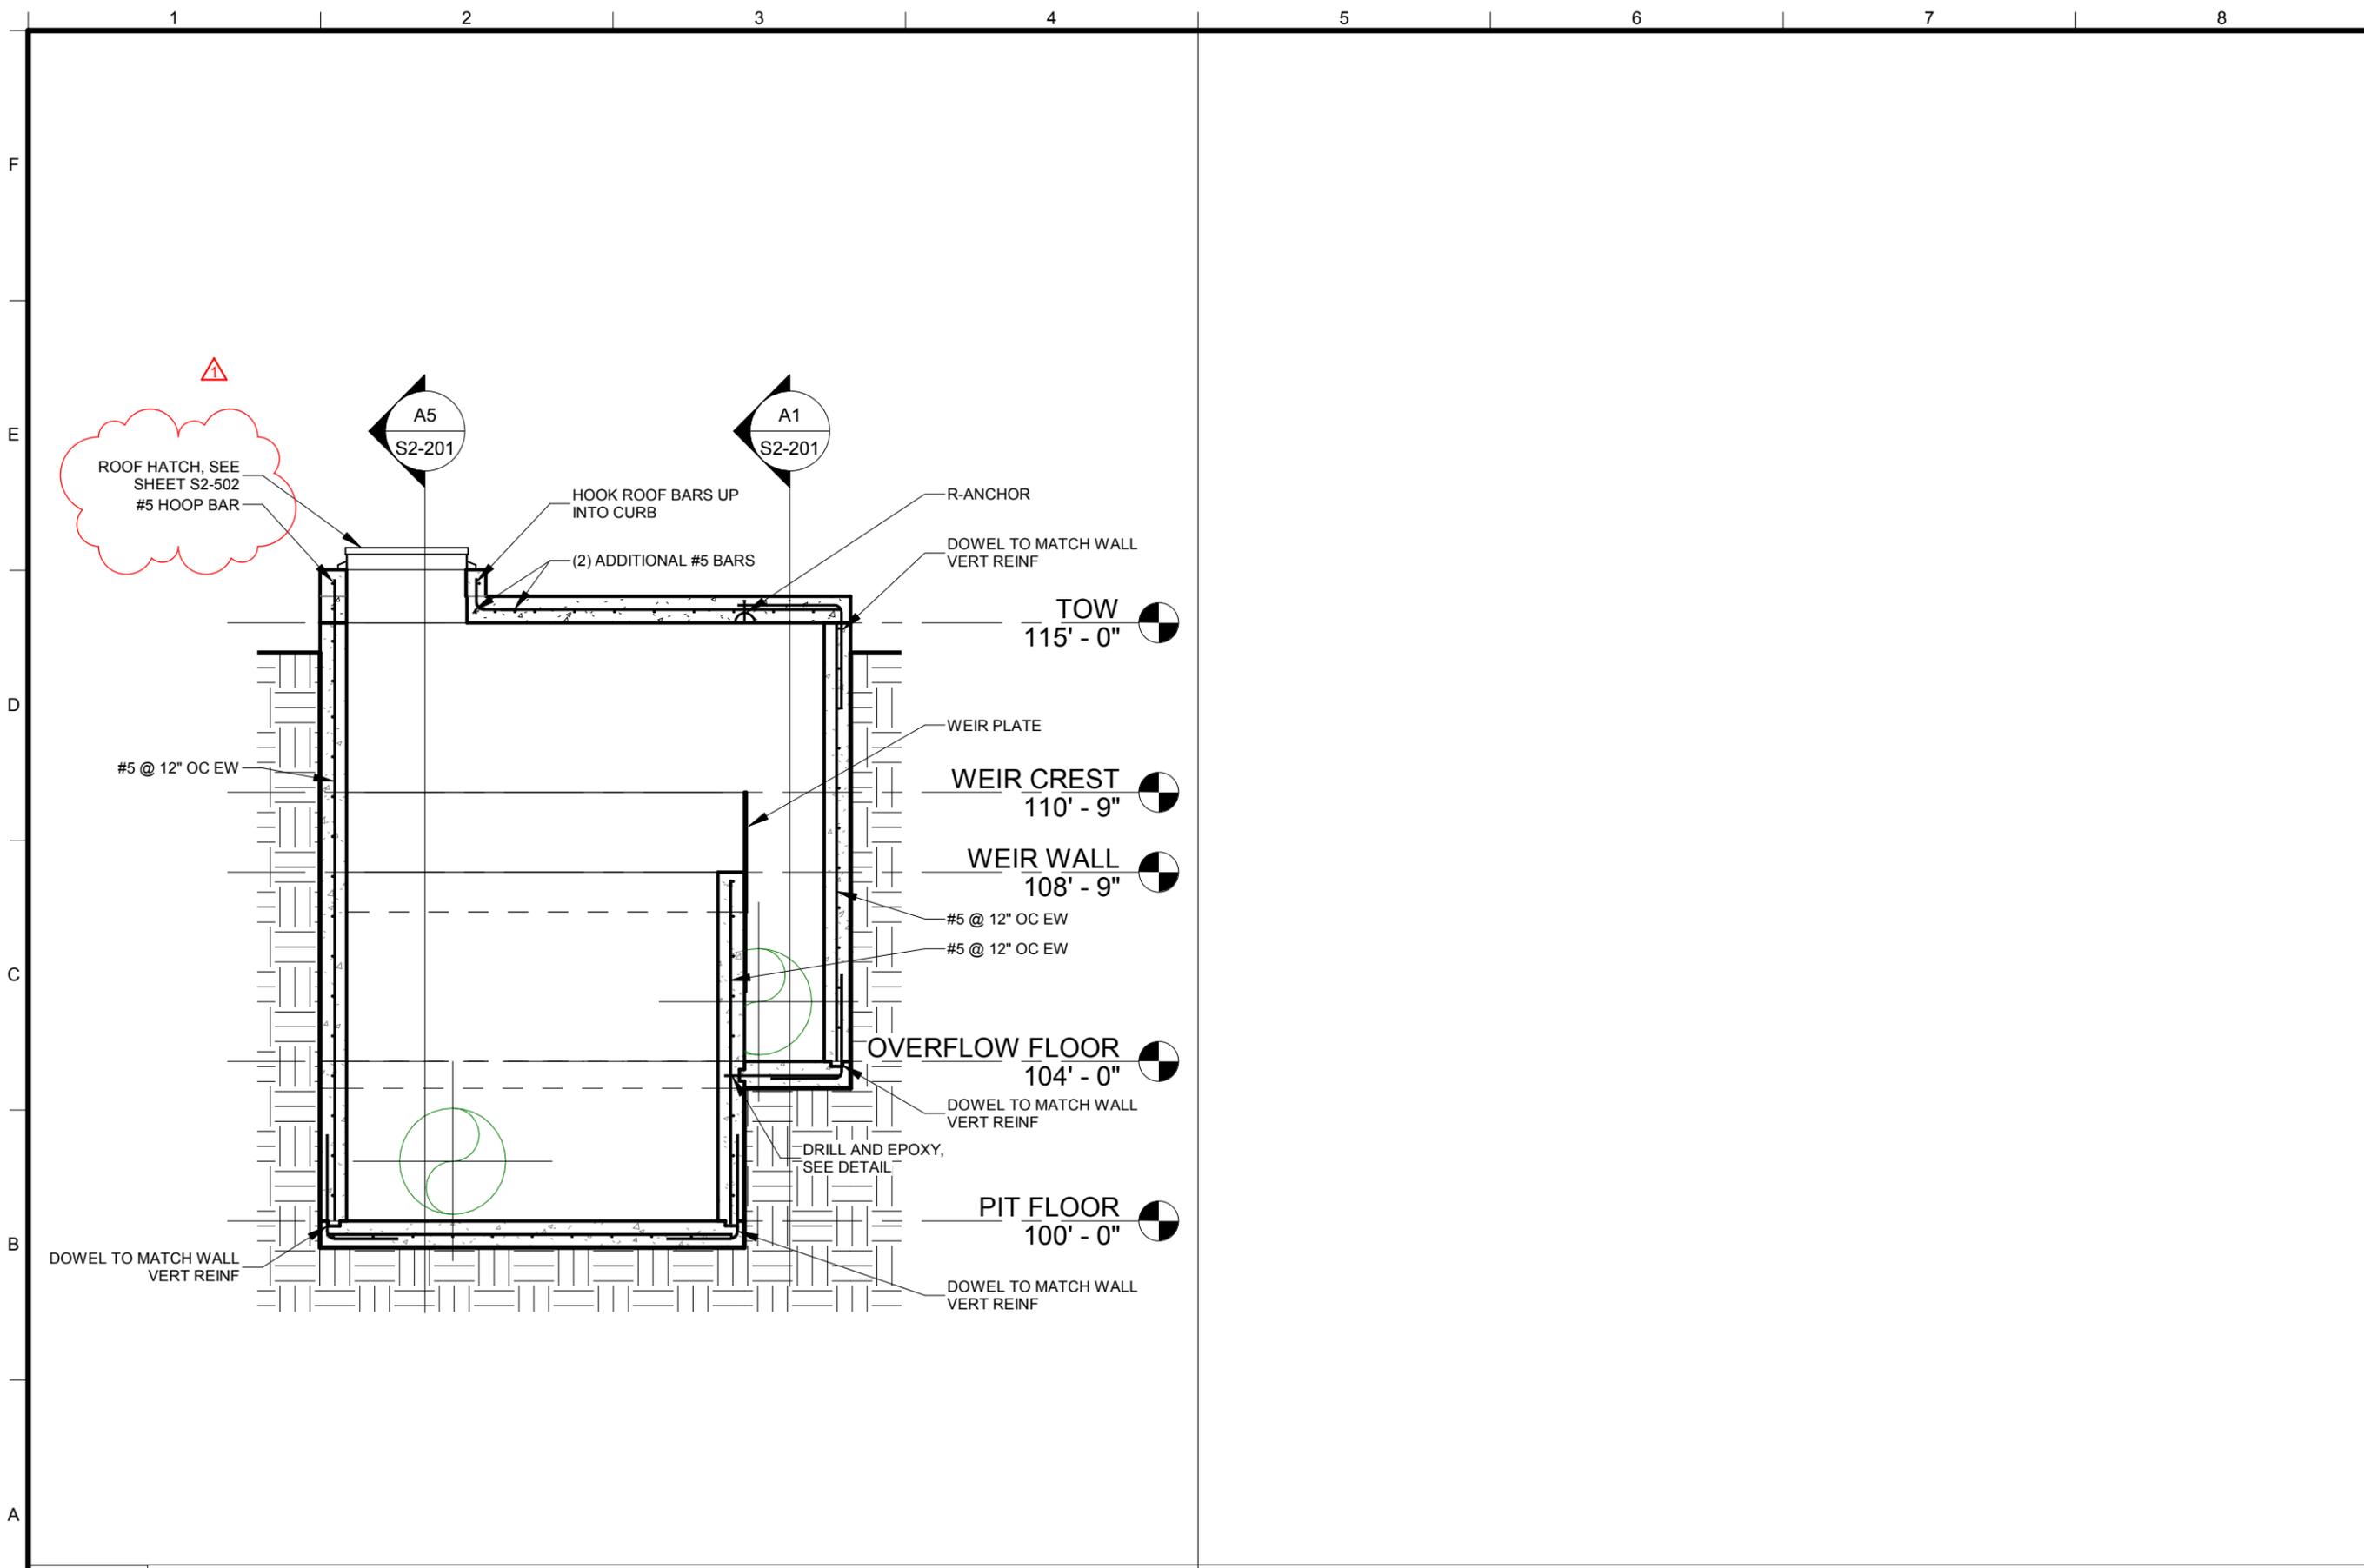

A1 SECTION

1/4" = 1'-0"

67718 Addendum 2 1 NO. DATE		REMARKS	
SCALE: 1/4" = 1'-0"		DWG NAME: H:\UD\Proj\1802-207\wg\Revit\Overflow Weir.rvt	
PROJECT DESIGN ENGINEER		REVISIONS	
APPROVAL RECOMM:		UPDATED: 6/7/2018 1:42:35 PM	
APPROVED		PROJECT NUMBER: 1802-207	
SPRINGVILLE CITY		UTAH COUNTY	
BARTHOLOMEW WATER TANK		STRUCTURAL SECTIONS	
PROJECT NUMBER: 1802-207		SHEET NO. S2-202	

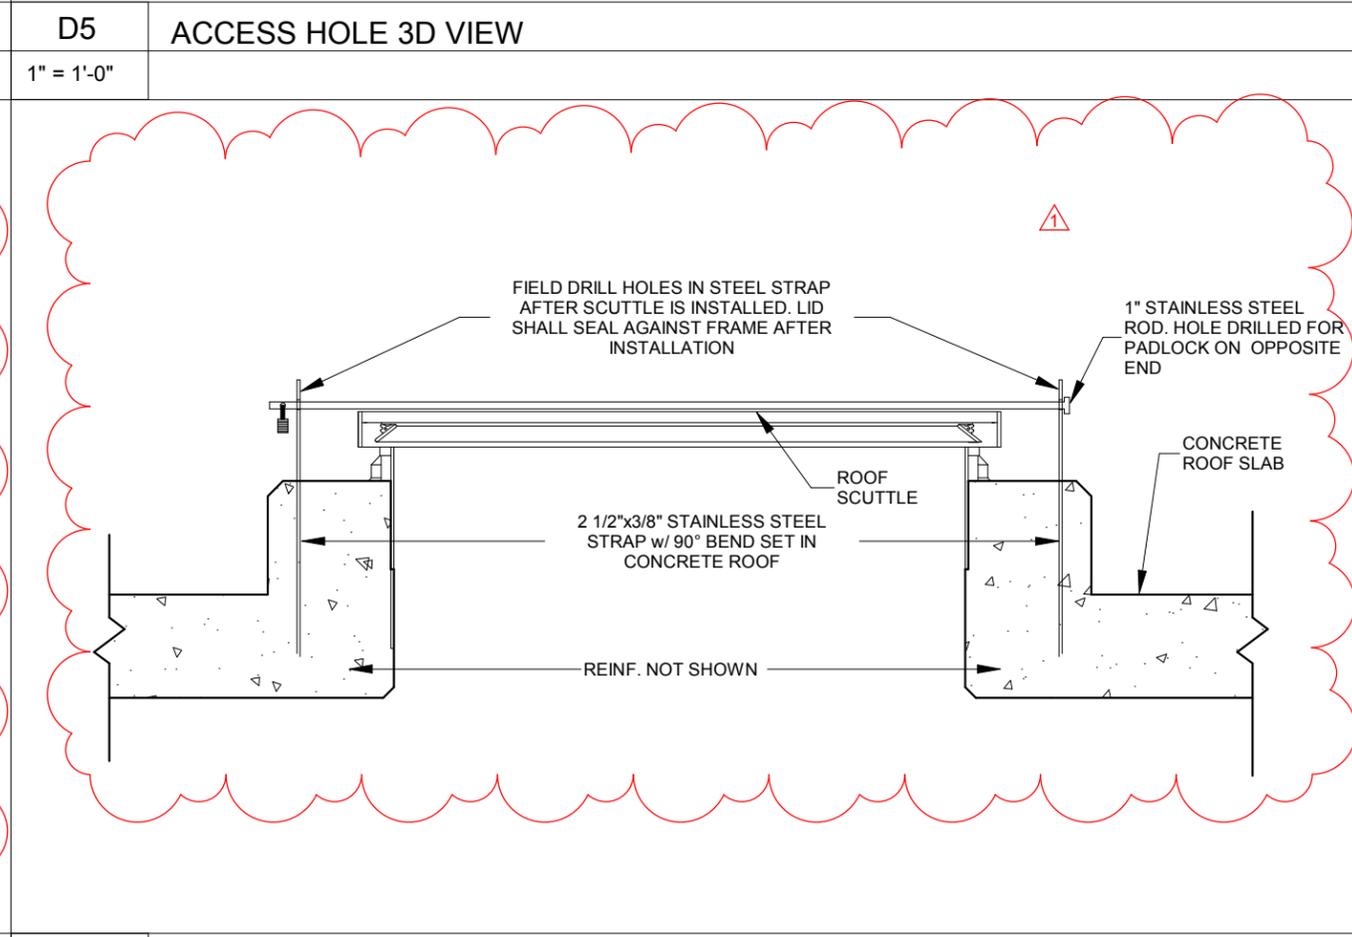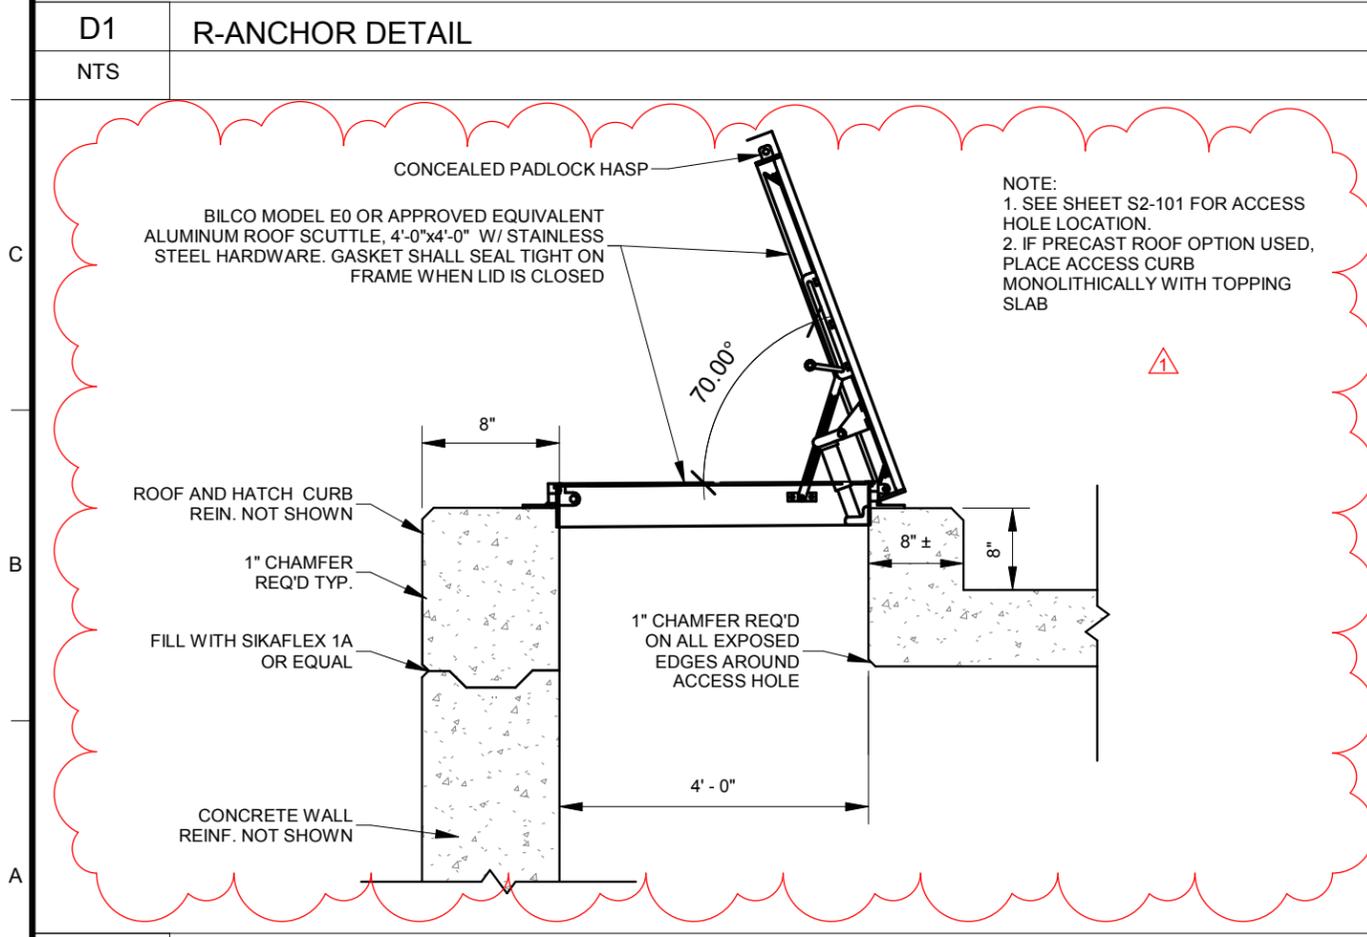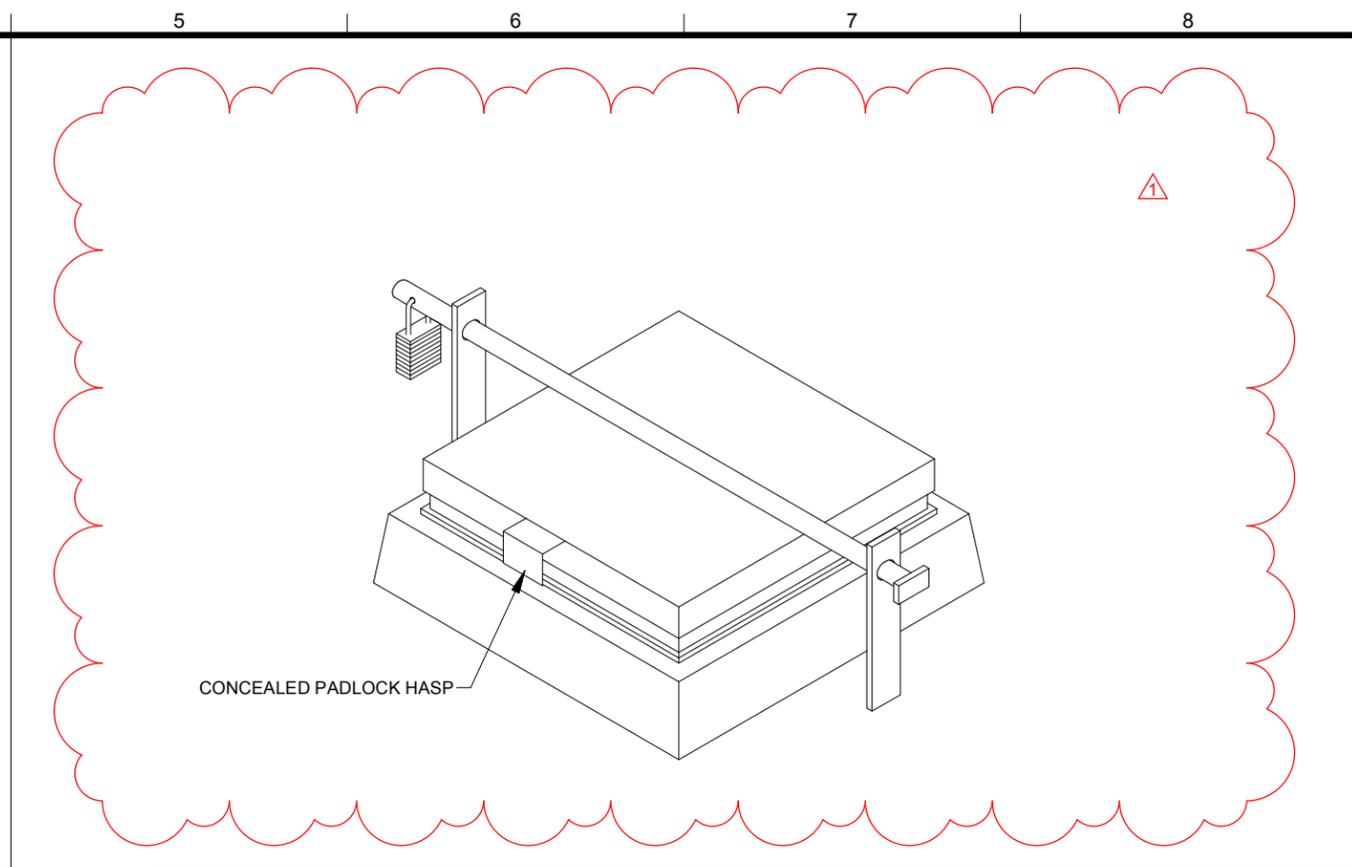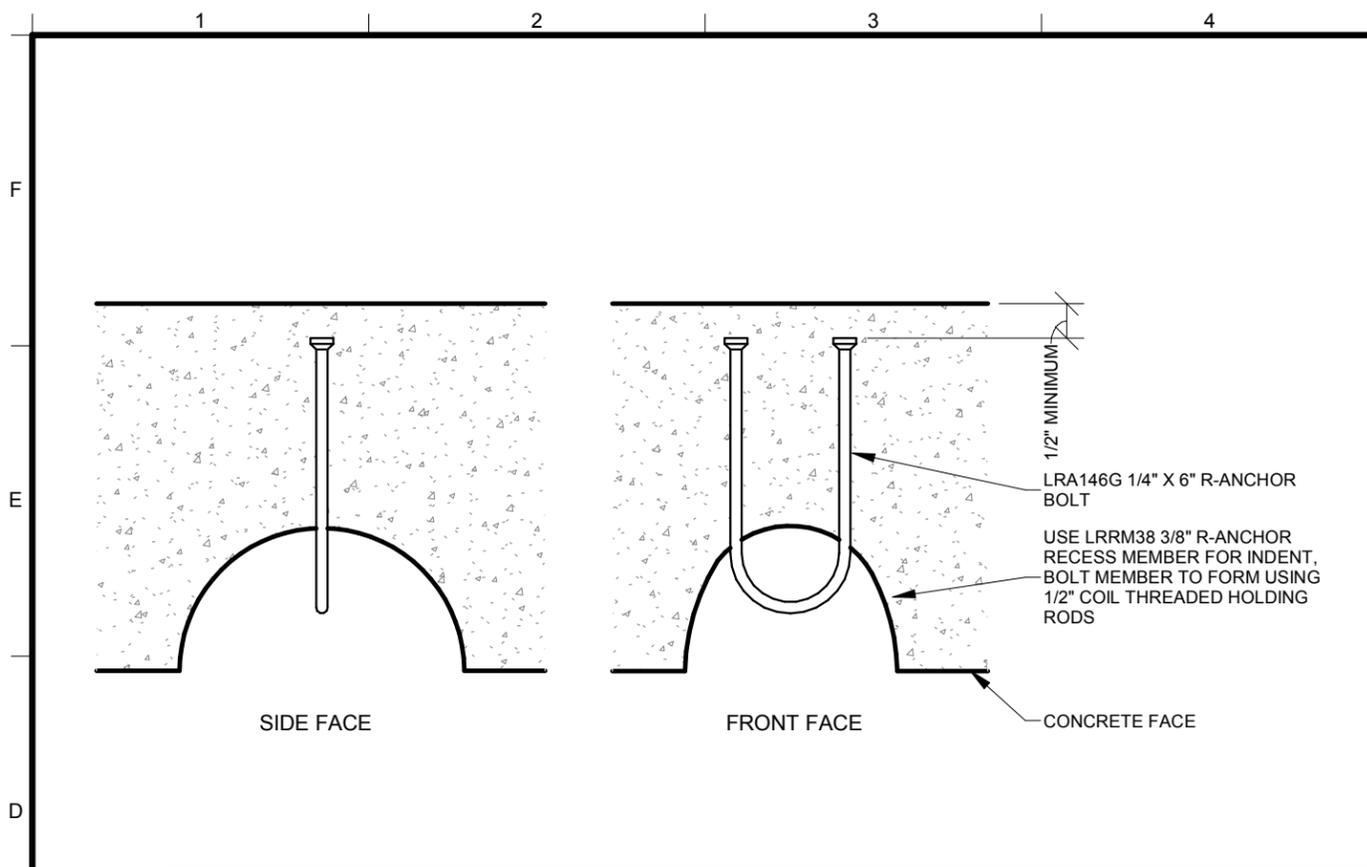

1 6/7/18 Addendum 2 NO. DATE		REMARKS	
SCALE: As indicated		DWG NAME: H:\UD\Proj\1802-207\dwg\Revit\Overflow Weir.rvt	
PROJECT DESIGN ENGINEER		PROJECT NO.	
APPROVAL		DATE:	
RECOMM.		DATE:	
APPROVED		DATE:	
Jones & DeMille Engineering, Inc. CIVIL ENGINEERING - SURVEYING - TESTING GIS - ENVIRONMENTAL 1.800.748.5275 www.jonesandmille.com			
SPRINGVILLE CITY BARTHOLOMEW WATER TANK			
STRUCTURAL DETAILS			
PROJECT NUMBER: 1802-207			
UTAH COUNTY			
SHEET NO. S2-502			

UPDATED: 6/7/2018 2:06:52 PM

REVISIONS

DATE: DATE:

DATE: DATE: